

**CALHOUN COUNTY REMONUMENTATION  
LAND CORNER RECORDATION CERTIFICATE  
Filing Requirement of Act 74, Mich. P.A. 1970**

**APPROVED**  
Date Sept 20 1995  
**CALHOUN COUNTY  
REMONUMENTATION.**

or corners in

<u>Calhoun</u> (County) <u>Clarendon Twp.</u>	Located In:	Corner Code #
Public Land Survey	T <u>4</u> S R <u>5</u> W	<u>G-10</u>
	T _____ R _____	_____
	T _____ R _____	_____
Property Controlling in Section	S _____ T _____ R _____	_____
Miscellaneous	S _____ T _____ R _____	_____
Property in Sec.	S _____ T _____ R _____	_____

STATE OF MICHIGAN  
CALHOUN COUNTY  
RECORDED

22 SEP 95 10:04 A.M.

ANNE R. NORLANDER  
Register of Deeds Stamp & File Number  
CLERK - REGISTER OF DEEDS

Lot No. \_\_\_\_\_, Recorded Plat \_\_\_\_\_  
Private Claims \_\_\_\_\_

Frederick J. Cutcher, in a field survey on September 15, 19 95,  
I hereby certify that under requirements of P.A. 74, Michigan P.A. of 1970, the corner points mentioned in lines 1 and 2 above were in conformance with regulations and rules therefore as required in the current manual of survey instructions of the United States Department of the Interior, Bureau of Land Management or by a decree of a Court of Law and/or that the corner points mentioned in lines 3, 4 and 5 above were in conformance with the rules of the Michigan Board of Land Surveyors or by a Decree of a Court of Law; established, re-established, monumented, re-monumented, recovered, found as expressed below:

A	B	C	D	E	F	G	H	I	J	K	L	M
2	6	5	4	3	2	1						
3												
4	7	8	9	10	11	12						
5												
6	18	17	16	15	14	13						
7												
8	19	20	21	22	23	24						
9												
10	30	29	28	27	26	25						
11												
12	31	32	33	34	35	36						
13												

**NOTE: Not more than 4 corners, all in the same town and range, may be recorded on this certificate.**

Description of original monument and accessories and/or subsequent restoration:  
Original Government Survey, December 1825: Maple 14" N 53° E 28 lks.; Beech 18" S 52° W 11 lks.

A. Watkins, 1965: Found iron; house corner foundation N 70° E 50.6'; 15" Box Elder N 40° E 77.2'; 15" Box Elder N 65° E 38.1'.


T.P.J. June 1976: Found flat iron plate, placed 1/2" pipe over; 4' East of centerline; 12" Elder N 45° E 37.80'; S.W. corner foundation house N 50° E 50.40'; 12" Locust East 60.65'.

J. Bush, 1979; House corner foundation N 70° E 50.38'; 15" Box Elder N 65° E 37.72'; chiseled "x" 2" dia. stone S 40° W 57.95'.

Description of corner evidence found and/or method applied in restoring or reestablishing corner:  
Found 1/2"x18" iron pipe 2" below road surface, over flat iron bar.  
5' East of centerline N/S road.

Two of above references were found.

Surveyor  
**REMONUMENTATION**  
  
FEB 22 1996  
  
COMMISSION

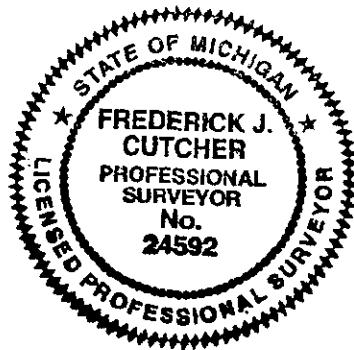

Description of monument for corner and accessories established to perpetuate locating the position of the corner:  
Replaced 1/2"x18" iron pipe with county issue Bernsten marker in monument box and is accepted as a careful and faithful reestablishment of the position of the original corner.  
Left flat iron bar.

In line with tree row to East, 5' East of centerline.  
Nail & spotter in 36" Box Elder N 25° E 77.27'.  
Nail & spotter in 24" Box Elder N 50 E 37.70'.  
Nail & spotter in 36" Box Elder N 65° W 38.05'.  
2" dia. stone "x" chisled on top S 35° W 58.10'.  
Top center telephone stancion N 10° E 113.28'.

LIBER 1822 PAGE 42

Signed by Frederick J. Cutcher Date September 19, 1995  
Surveyor's Michigan License No. 24592