

APPROVED

ate 7-27-94 1994
CALHOUN COUNTY
EMONUMENTATION.

Calhoun County Remonumentation

LAND CORNER RECORDATION CERTIFICATE
Filing Requirement of Act 74, Mich. P.A. 1970

STATE OF MICHIGAN
CALHOUN COUNTY
RECORDED

For corners in
Calhoun

(County)

Located In:

Corner Code ##

- 1. Public Land Survey T 4 S R 5 W I-3
- T _____ R _____
- T _____ R _____
- T _____ R _____
- 2. Property Controlling S _____ T _____ R _____
- in Section S _____ T _____ R _____
- 3. Miscellaneous S _____ T _____ R _____
- Property in Sec. S _____ T _____ R _____

28 JUL 94 11:15 A.M.

ANNE B. NORLANDER
CLERK - REGISTER OF DEEDS


Register of Deeds Stamp & File Number

- 4. Lot No. _____, Recorded Plat _____
- 5. Private Claims _____

I, Donald J. Davis, in a field survey on July 7, 1994, do hereby certify that under requirements of P.A. 74, Michigan P.A. of 1970, the corner points mentioned in lines 1 and 2 above were in conformance with regulations and rules therefore as required in the current manual of survey instructions of the United States Department of the Interior, Bureau of Land Management or by a decree of a Court of Law and/or that the corner points mentioned in lines 3, 4 and 5 above were in conformance with the rules of the Michigan Board of Land Surveyors or by a Decree of a Court of Law; established, re-established, monumented, re-monumented, recovered, found as expressed below:

NOTE: Not more than 4 corners, all in the same town and range, may be recorded on this certificate.

A. Description of original monument and accessories and/or subsequent restoration:
Clark, 1826
18" Black Oak N 54° E 140 links
5" Maple S 40° E 31½ links.

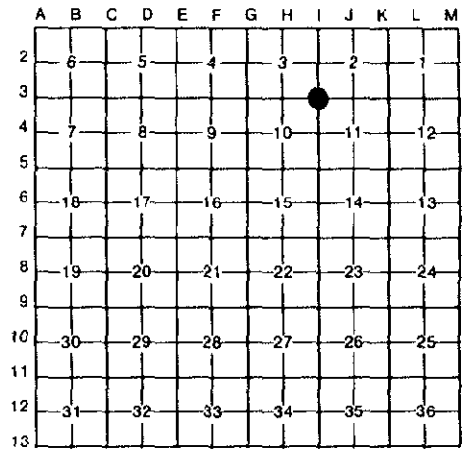

SURVEY &
REMONUMENTATION

OCT 24 1994

COMMISSION

B. Description of corner evidence found and/or method applied in restoring or reestablishing corner:
Set corner on line between the SE corner of Section 10 and the NE corner of Section 3 at a distance to match occupation and the prorate of the Government distances.

Excavated and found no evidence of corner.

LIBER 1760 PAGE 646

C. Description of monument for corner and accessories established to perpetuate locating the position of the corner:
Set Berntsen monument and monument box.
Bottom steel post in East side of cement corner post S 45° W 48.00'
Nail & Spotter 14" Hickory S 25° E 102.60'.
Nail & Spotter 8" Locust N 20° E 117.40'
SW corner of Southerly boulder N 50° W 56.40'



Signed by Donald J. Davis

Date July 25, 1994

Surveyor's Michigan License No. 17617