

APPROVED
 Date Sept. 20 1995
CALHOUN COUNTY
REMONUMENTATION.

CALHOUN COUNTY REMONUMENTATION
LAND CORNER RECORDATION CERTIFICATE
 Filing Requirement of Act 74, Mich. P.A. 1970

For corners in

<u>Calhoun</u> (County) <u>Clarendon Twp.</u>	Located In:	Corner Code #
1. Public Land Survey	T <u>4</u> S R <u>5</u> W	<u>I-9</u>
	T _____ R _____	_____
	T _____ R _____	_____
	T _____ R _____	_____
2. Property Controlling in Section	S _____ T _____ R _____	_____
	S _____ T _____ R _____	_____
3. Miscellaneous Property in Sec.	S _____ T _____ R _____	_____
	S _____ T _____ R _____	_____
4. Lot No. _____, Recorded Plat _____		
5. Private Claims _____		

STATE OF MICHIGAN
 CALHOUN COUNTY
 RECORDED

22 SEP 95 10:03 A.M.

ANNE B. NORLANDER
 CLERK - REGISTER OF DEEDS

Register of Deeds Stamp & File Number

	A	B	C	D	E	F	G	H	I	J	K	L	M
2	6	5	4	3	2	1							
3													
4	7	8	9	10	11	12							
5													
6	18	17	16	15	14	13							
7													
8	19	20	21	22	23	24							
9					⊕								
10	30	29	28	27	26	25							
11													
12	31	32	33	34	35	36							
13													

Frederick J. Cutcher, in a field survey on September 14, 19 95, do hereby certify that under requirements of P.A. 74, Michigan P.A. of 1970, the corner points mentioned in lines 1 and 2 above were in conformance with regulations and rules therefore as required in the current manual of survey instructions of the United States Department of the Interior, Bureau of Land Management or by a decree of a Court of Law and/or that the corner points mentioned in lines 3, 4 and 5 above were in conformance with the rules of the Michigan Board of Land Surveyors or by a Decree of a Court of Law; established, re-established, monumented, re-monumented, recovered, found as expressed below:

NOTE: Not more than 4 corners, all in the same town and range, may be recorded on this certificate.

4. Description of original monument and accessories and/or subsequent restoration:

Corner common to Sections 22, 23, 26 & 27, Town 4 South, Range 5 West.
 Original Government Survey, December 1825: W. Oak 14" N 46° E 27 lks.; W. Oak 14' S 63½° E 50 lks.
 W. Gunn, 1927: 10" Maple N 59° W 51.4'; 10" Maple N 31° W 49.3'; 8" Maple N 24° W 64.0'; 8" Elm N 44° E 47.2'.
 Salsgaber, 1956: Lg. stone; 10" Maple N 59° W 51.4'; 10" Maple N 31° W 49.3'; 8" Maple N 24° W 64.0'; 8" Elm N 44° E 47.2'.
 1/23/69: R.R. spike; S.E. cor. bldg. found. NW 112.5'; S.W. cor. house found. NE 123.8'; NW cor. store found. SE 76.7'; PK nail 40" Oak S 75° W 103.8'. (Cal. County Rd. Comm.)

3. Description of corner evidence found and/or method applied in restoring or reestablishing corner:


Found 1/2"x10" iron rod in monument box set by Calhoun County Road Commission in the 1980's. Monument box was over stone and brick in centerline of intersections N/S & E/W roads, and has been used in numerous surveys.

Three of the above references were found.

REMONUMENTATION

FEB 22 1996

COMMISSION

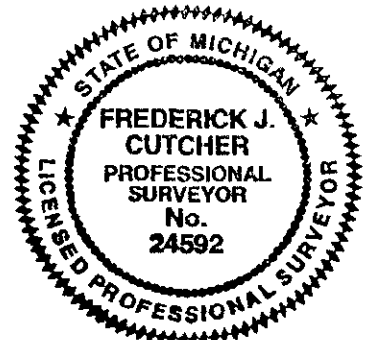

2. Description of monument for corner and accessories established to perpetuate locating the position of the corner:

Replaced 1/2"x10" iron rod with county issue Bernsten marker in a new monument box and is accepted as a careful and faithful reestablishment of the position of the original corner.

In centerline intersection of N/S & E/W roads.
 N.W. corner store foundation S 35° E 76.70'.
 Nail & spotter Power Pole S 47° W 62.20'.
 Top center telephone stanchion S 64° W 61.05'.
 S.E. corner house foundation N 38° W 112.45'.
 Nail & spotter 10" Maple N 50° E 58.90'.

LIBER 1822 PAGE 39

Signed by Frederick J. Cutcher Date September 19, 1995
 Frederick J. Cutcher
 Surveyor's Michigan License No. 24592