

LAND CORNER RECORDATION CERTIFICATE
Filing Requirement of Act 74, Mich. P.A. 1970

For corners in


<u>Calhoun</u> <small>(County)</small>	Located In:	Corner Code //
1. Public Land Survey	T 4S R 6W	3-A
	T 4S R 6W	3-B
	T 4S R 6W	3-C
	T R	
2. Property Controlling in Section	S T R	
	S T R	
3. Miscellaneous Property in Sec.	S T R	
	S T R	

Register of Deeds Stamp & File Number

4. Lot No. _____, Recorded Plat _____
 5. Private Claims _____

I, Donald L. Bissell in a field survey on June, 19 88, do hereby certify that under requirements of P.A. 74, Michigan P.A. of 1970, the corner points mentioned in lines 1 and 2 above were in conformance with regulations and rules therefore as required in the current manual of survey instructions of the United States Department of the Interior, Bureau of Land Management or by a decree of a Court of Law and/or that the corner points mentioned in lines 3, 4 and 5 above were in conformance with the rules of the Michigan Board of Land Surveyors or by a Decree of a Court of Law; established, re-established, monumented, re-monumented, recovered, found as expressed below:

NOTE: Not more than 4 corners, all in the same town and range, may be recorded on this certificate.

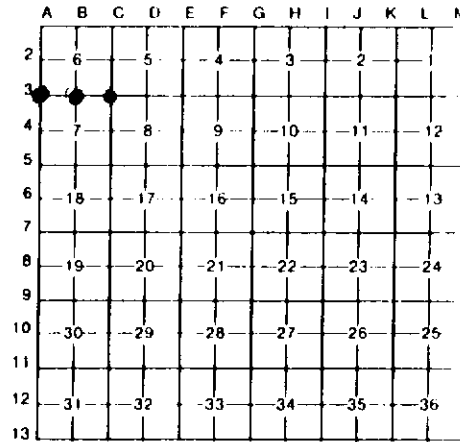

A. Description of original monument and accessories and/or subsequent restoration:

B. Description of corner evidence found and/or method applied in restoring or reestablishing corner:

- | | | |
|--|--|--|
| <p>3-A
Found iron at intersection of "N" Drive S. and 12 Mile Rd. From Witness Info Provided by Donald J. Davis, RLS # 17617</p> | <p>3-B
Set 4" x 36" Conc. Mon. with D.N.R. Cap. Set on line between S.W. Cor. & S.E. Cor. on line with fence to South.</p> | <p>3-C
Found iron and stone from witness info provided by Donald J. Davis, RLS # 17617</p> |
|--|--|--|

C. Description of monument for corner and accessories established to perpetuate locating the position of the corner:

- | | | |
|--|--|---|
| <p>3-A
S.W. Cor. Sec. 6 T4S, R6W
24" Hickory - N70°E - 43.85'
24" Maple - S30°E - 34.92'</p> | <p>3-B
¼ Cor. Sec. 6, T4S, R6W
48" Twin Willow - S60°W - 17.81'
6" W. Ash - S75°E - 8.58'
6" Silver Maple - N27°E - 27.61'
60' Triple Willow - S83°E - 78.99'
50' W on Sec. line to Water's edge of Warner Lake
20' N to Water's edge of Warner Lake</p> | <p>3-C
¼ Cor. Sec. 6, T4S, R6W
8" Hickory - S45°W - 8.5'
6" Ash - N45°W - 33.6'</p> |
|--|--|---|

Signed by Donald L. Bissell

Surveyor's Michigan License No. 18655

