

1993

COMMISSION

CALHOUN COUNTY REMONUMENTATION

LAND CORNER RECORDATION CERTIFICATE Nov 19 1 00 PM 93

Filing Requirement of Act 74, Mich. P.A. 1970

For corners in Calhoun County (County)

Located In:

Corner Code ##

- 1. Public Land Survey T 4 S R 6 W G-10
2. Property Controlling in Section S T R
3. Miscellaneous Property in Sec. S T R

CLERK-REGISTERED CALHOUN COUNTY, MICH. ANNE P. NORDLANDER

Register of Deeds Stamp & File Number

- 4. Lot No. Recorded Plat
5. Private Claims

Donald J. Davis, in a field survey on November 1, 19 93, do hereby certify that under requirements of P.A. 74, Michigan P.A. of 1970, the corner points mentioned in lines 1 and 2 above were in conformance with regulations and rules therefore as required in the current manual of survey instructions of the United States Department of the Interior, Bureau of Land Management or by a decree of a Court of Law and/or that the corner points mentioned in lines 3, 4 and 5 above were in conformance with the rules of the Michigan Board of Land Surveyors or by a Decree of a Court of Law; established, re-established, monumented, re-monumented, recovered, found as expressed below:

Grid table with columns A-M and rows 2-13. A dot is marked at the intersection of column G and row 10.

NOTE: Not more than 4 corners, all in the same town and range, may be recorded on this certificate.

A. Description of original monument and accessories and/or subsequent restoration:

Tile set in resurvey from original bearing tree stumps.

12" Elm S 1/2° E 70 Links.

8" Tamarack N 64° W 44 Links

Tile found in 1972 and 3/4" pipe set in tile.

East edge of ditch South.

South edge of ditch West.

B. Description of corner evidence found and/or method applied in restoring or reestablishing corner:

Found tile and 3/4" pipe in rocks.

Accepted this as true perpetuation of corner location.

Corner used by MDSH for construction of Highway I-69.

LIBER 1716 PAGE 634

C. Description of monument for corner and accessories established to perpetuate locating the position of the corner:

Set Berntsen monument over bottom section of tile.

East edge ditch to South.

South edge ditch to West.


Nail & tag 20" Burr Oak East 31.35'

Nail & tag 10" Burr Oak N 10° E 42.40'

Nail & Tag 16" Burr Oak N 30° W 54.80'

Nail & tag 10" Maple S 15° E 12.00'

Old fence to North.

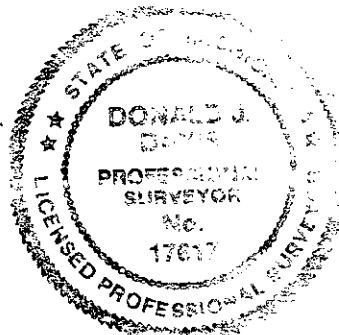

Signed by Donald J. Davis

Date November 10, 1993

Surveyor's Michigan License No. 17617