

SURVEY &
REMONUMENTATION

1993

CALHOUN COUNTY REMONUMENTATION

COMMISSION

LAND CORNER RECORDATION CERTIFICATE
Filing Requirement of Act 74, Mich. P.A. 1970

RECORDED

Nov 19 1 00 PM 93

For corners in

Calhoun County
(County)

Located In: _____ Corner Code # _____

1. Public Land Survey	T <u>4</u> S R <u>6</u> W	<u>H-9</u>
	T _____ R _____	_____
	T _____ R _____	_____
	T _____ R _____	_____
2. Property Controlling in Section	S _____ T _____ R _____	_____
	S _____ T _____ R _____	_____
3. Miscellaneous Property in Sec.	S _____ T _____ R _____	_____
	S _____ T _____ R _____	_____
4. Lot No. _____, Recorded Plat _____		
5. Private Claims _____		

CLERK-REGISTRAR
CALHOUN COUNTY, MICHIGAN
ANNE B. ...

Register of Deeds Stamp & File Number

I, Donald J. Davis, in a field survey on November 12, 19 93, do hereby certify that under requirements of P.A. 74, Michigan P.A. of 1970, the corner points mentioned in lines 1 and 2 above were in conformance with regulations and rules therefore as required in the current manual of survey instructions of the United States Department of the Interior, Bureau of Land Management or by a decree of a Court of Law and/or that the corner points mentioned in lines 3, 4 and 5 above were in conformance with the rules of the Michigan Board of Land Surveyors or by a Decree of a Court of Law; established, re-established, monumented, re-monumented, recovered, found as expressed below:

	A	B	C	D	E	F	G	H	I	J	K	L	M
2	6	5	4	3	2	1							
3													
4	7	8	9	10	11	12							
5													
6	18	17	16	15	14	13							
7													
8	19	20	21	22	23	24							
9													
10	30	29	28	27	26	25							
11													
12	31	32	33	34	35	36							
13													


NOTE: Not more than 4 corners, all in the same town and range, may be recorded on this certificate.

A. Description of original monument and accessories and/or subsequent restoration:
 Tile set in resurvey of 1893 by Gifford.
 8" Elm S 87° E 105 Links.
 8" Maple S 72° E 111 Links.
 MDSH established in 1963 and set boat spike. R. Lester found boat spike and set capped iron.
 Iron post S 26° E 114.53'
 Corner post S 88° E 66.56' Recorded Liber 1124, page 740.

B. Description of corner evidence found and/or method applied in restoring or reestablishing corner:
 Found capped iron 2 feet under. Ran traverse of F. Cutcher using Lester iron.
 Iron in plowed field.

LIBER 1716 PAGE 629

C. Description of monument for corner and accessories established to perpetuate locating the position of the corner:
 Set Harrison monument for point. Monument set 2 feet under field.
 In line with fence East.
 65 feet West of fence South.
 Nail & Tag 6" White Pine S 70° E 70.45'
 Nail & tag 10" Cherry S 30° E 161.00'
 Nail & tag 16" Cherry S 35° W 404.80'

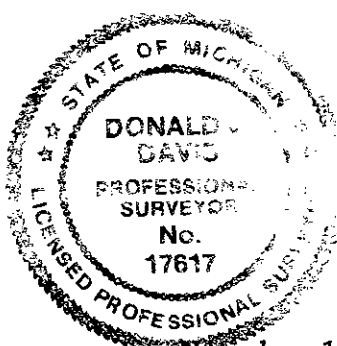

Signed by Donald J. Davis
 Surveyor's Michigan License No. 17617

Date November 16, 1993