

**SURVEY &  
REMONUMENTATION**

1993

CALHOUN COUNTY REMONUMENTATION

RECORDED

COMMISSION

**LAND CORNER RECORDATION CERTIFICATE**  
Filing Requirement of Act 74, Mich. P.A. 1970

NOV 19 1 01 PM 93

For corners in

Calhoun County  
(County)

Located In:

Corner Code #

- |                                    |                           |             |
|------------------------------------|---------------------------|-------------|
| 1. Public Land Survey              | T <u>4</u> S R <u>6</u> W | <u>H-11</u> |
|                                    | T _____ R _____           | _____       |
|                                    | T _____ R _____           | _____       |
|                                    | T _____ R _____           | _____       |
| 2. Property Controlling in Section | S _____ T _____ R _____   | _____       |
|                                    | S _____ T _____ R _____   | _____       |
| 3. Miscellaneous Property in Sec.  | S _____ T _____ R _____   | _____       |
|                                    | S _____ T _____ R _____   | _____       |

CLERK-REGISTRAR  
CALHOUN COUNTY, MICH.  
ANNE S. MCDONALD

Register of Deeds Stamp & File Number

4. Lot No. \_\_\_\_\_, Recorded Plat \_\_\_\_\_  
5. Private Claims \_\_\_\_\_

I, Donald J. Davis, in a field survey on November 1, 19 93, do hereby certify that under requirements of P.A. 74, Michigan P.A. of 1970, the corner points mentioned in lines 1 and 2 above were in conformance with regulations and rules therefore as required in the current manual of survey instructions of the United States Department of the Interior, Bureau of Land Management or by a decree of a Court of Law and/or that the corner points mentioned in lines 3, 4 and 5 above were in conformance with the rules of the Michigan Board of Land Surveyors or by a Decree of a Court of Law; established, re-established, monumented, re-monumented, recovered, found as expressed below:

**NOTE: Not more than 4 corners, all in the same town and range, may be recorded on this certificate.**

A	B	C	D	E	F	G	H	I	J	K	L	M
2	6	5	4	3	2	1						
3												
4	7	8	9	10	11	12						
5												
6	18	17	16	15	14	13						
7												
8	19	20	21	22	23	24						
9												
10	30	29	28	27	26	25						
11												
12	31	32	33	34	35	36						
13												

A. Description of original monument and accessories and/or subsequent restoration:

- Tile set in resurvey from Government information.
- 15" Yellow Oak S 3/4° W 272 Links.
- Buggy axle placed for corner in 1942.
- Axle found by MDSH in 1963.
- 18" Twin Elm S 45° E 107.50'
- 21" Hickory S 21° W 9.60'


B. Description of corner evidence found and/or method applied in restoring or reestablishing corner:

- Found buggy axle and rocks around 1 foot west of chain link fence.
- Accepted as good location of original corner.

LIBER 1716 PAGE 635

C. Description of monument for corner and accessories established to perpetuate locating the position of the corner:

- Set Berntsen monument with rocks around, 1 foot West of chain link fence.
- Nail & tag 16" Red Oak N 05° E 23.20'
- Nail & tag 14" Cherry S 45° E 94.50'
- Nail & tag 26" Hickory S 10° W 8.87'
- Nail & tag Power Pole N 30° W 26.26'

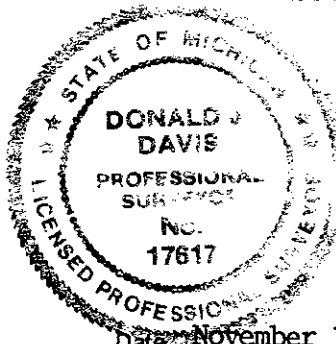

Signed by

*Donald J. Davis*

Date: November 10, 1993

Surveyor's Michigan License No. 17617