

1993

CALHOUN COUNTY REMONUMENTATION

RECORDED

COMMISSION

LAND CORNER RECORDATION CERTIFICATE
Filing Requirement of Act 74, Mich. P.A. 1970

Nov 14 1 00 PM '93

For corners in
Calhoun County
(County)

Located In:

Corner Code #

- 1. Public Land Survey T 4 S R 6 W I-9
- T _____ R _____
- T _____ R _____
- T _____ R _____
- 2. Property Controlling S _____ T _____ R _____
- in Section S _____ T _____ R _____
- 3. Miscellaneous S _____ T _____ R _____
- Property in Sec. S _____ T _____ R _____

CLERK-REGISTRAR
CALHOUN COUNTY
ANNE R. M... 1993

Register of Deeds Stamp & File Number

- 4. Lot No. _____, Recorded Plat _____
- 5. Private Claims _____

I, Donald J. Davis, in a field survey on November 1, 19 93, do hereby certify that under requirements of P.A. 74, Michigan P.A. of 1970, the corner points mentioned in lines 1 and 2 above were in conformance with regulations and rules therefore as required in the current manual of survey instructions of the United States Department of the Interior, Bureau of Land Management or by a decree of a Court of Law and/or that the corner points mentioned in lines 3, 4 and 5 above were in conformance with the rules of the Michigan Board of Land Surveyors or by a Decree of a Court of Law; established, re-established, monumented, re-monumented, recovered, found as expressed below:

A	B	C	D	E	F	G	H	I	J	K	L	M
2	6	5	4	3	2	1						
3												
4	7	8	9	10	11	12						
5												
6	18	17	16	15	14	13						
7												
8	19	20	21	22	23	24						
9												
10	30	29	28	27	26	25						
11												
12	31	32	33	34	35	36						
13												

NOTE: Not more than 4 corners, all in the same town and range, may be recorded on this certificate.

A. Description of original monument and accessories and/or subsequent restoration:

Resurvey tile set at location of old wood stake.
Hex monument set over tile and found in 1977.

- 16" Hickory N 37° E 221.73'
- 15" Twin Oak N 51° E 43.83' By DeKeyser in 1977.
- Power Pole S 07° W 26.37'

B. Description of corner evidence found and/or method applied in restoring or reestablishing corner:


Found Hex concrete monument, boat spike and pieces of tile. Location matches witnesses and has been used for local surveys.

Accepted this as a good perpetuation of the true corner location.

LIBER 1716 PAGE 632

C. Description of monument for corner and accessories established to perpetuate locating the position of the corner:

- Set Berntsen monument in monument box.
- Nail & tag (MDOT) Guy pole N 25° W 26.00'
- Nail & tag 16" Box Elder N 55° E 85.30'
- Nail & tag 24" White Oak N 50° E 44.05'
- Nail & tag Power Pole S 07° W 26.55'

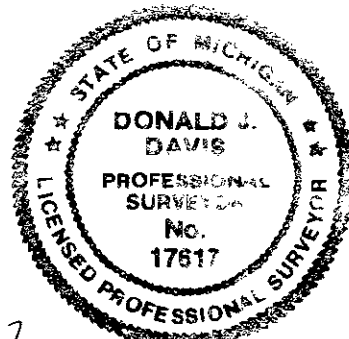

Signed by Donald J. Davis Date November 10, 1993

Surveyor's Michigan License No. 17617