

1993

Calhoun County Remonumentation

LAND CORNER RECORDATION CERTIFICATE  
Filing Requirement of Act 74, Mich. P.A. 1970

RECORDED

Nov 14 1 00 PM 93

COMMISSION

For corners in

Calhoun County  
(County)

Located In:

Corner Code #

- 1. Public Land Survey T 4 S R 6 W I-11  
T \_\_\_\_\_ R \_\_\_\_\_  
T \_\_\_\_\_ R \_\_\_\_\_  
T \_\_\_\_\_ R \_\_\_\_\_
- 2. Property Controlling S \_\_\_\_\_ T \_\_\_\_\_ R \_\_\_\_\_  
in Section S \_\_\_\_\_ T \_\_\_\_\_ R \_\_\_\_\_
- 3. Miscellaneous S \_\_\_\_\_ T \_\_\_\_\_ R \_\_\_\_\_  
Property in Sec. S \_\_\_\_\_ T \_\_\_\_\_ R \_\_\_\_\_

CLERK REGISTERED  
CALHOUN COUNTY, MICH.  
ANNE B. H. BLENDE

Register of Deeds Stamp & File Number

- 4. Lot No. \_\_\_\_\_, Recorded Plat \_\_\_\_\_
- 5. Private Claims \_\_\_\_\_

I, Donald J. Davis, in a field survey on November 1, 19 93, do hereby certify that under requirements of P.A. 74, Michigan P.A. of 1970, the corner points mentioned in lines 1 and 2 above were in conformance with regulations and rules therefore as required in the current manual of survey instructions of the United States Department of the Interior, Bureau of Land Management or by a decree of a Court of Law and/or that the corner points mentioned in lines 3, 4 and 5 above were in conformance with the rules of the Michigan Board of Land Surveyors or by a Decree of a Court of Law; established, re-established, monumented, re-monumented, recovered, found as expressed below:

**NOTE: Not more than 4 corners, all in the same town and range, may be recorded on this certificate.**

A. Description of original monument and accessories and/or subsequent restoration:

Point reset in resurvey and tile placed.  
30" Elm N 84½° W 832 Links.

Concrete monument place over tile by Chase.

B. Description of corner evidence found and/or method applied in restoring or reestablishing corner:

Found concrete monument and tile 30 feet South of centerline paving.


Accepted this location as perpetuation of true corner.

A	B	C	D	E	F	G	H	I	J	K	L	M
2	6	5	4	3	2	1						
3												
4	7	8	9	10	11	12						
5												
6	18	17	16	15	14	13						
7												
8	19	20	21	22	23	24						
9												
10	30	29	28	27	26	25						
11												
12	31	32	33	34	35	36						
13												

LIBER 1716 PAGE 633

C. Description of monument for corner and accessories established to perpetuate locating the position of the corner:

Set Berntsen monument with tile beside.  
Nail & tag Triple 8" Cherry N 40° W 141.95'  
Nail & tag 24" Walnut N 60° W 174.80'  
Nail & tag RR tie post N 65° E 226.96'  
Pipe in 14" concrete fence post N 55° W 103.45'  
30 feet South of centerline East and West road.  
83 feet East of East cemetery fence.

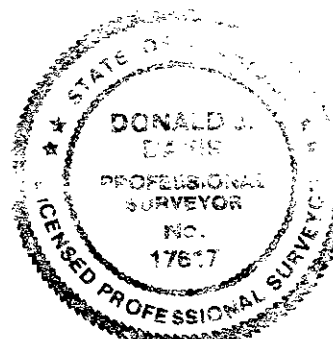

Signed by

*Donald J. Davis*

Date November 10, 1993

Surveyor's Michigan License No. 17617