

**APPROVED**

Date 2-24-99 PRC  
**CALHOUN COUNTY**  
**REMONUMENTATION.**

**BRANCH COUNTY REMONUMENTATION PROGRAM**  
**LAND CORNER RECORDATION CERTIFICATE**  
Filing Requirement of Act 74, Mich. P.A. 1970

STATE OF MICHIGAN  
CALHOUN COUNTY  
RECORDED

2 JUL 1999 2:27:18 PM

ANNE N. NORLANDER  
CLERK - REGISTER OF DEEDS

LIBER **2141** PAGE **242**

Register of Deeds Stamp & File Number

ACCEPTED BY THE BRANCH COUNTY  
SURVEY PEER GROUP AS THE OFFICIAL  
CORNER UNDER MICHIGAN PUBLIC ACT 345  
OF 1990 AT A MEETING HELD ON  
11-04-1998

E.R. Reed, P.S. Co. Rep.  
E.R. REED

For corners in

<u>CALHOUN COUNTY</u> TEKONSHA TWP	Located In:	Corner Code #
1. Public Land Survey	T <u>4</u> S R <u>6</u> W	<u>M-13</u>
	T _____ R _____	_____
	T _____ R _____	_____
	T _____ R _____	_____
2. Property Controlling in Section	S _____ T _____ R _____	_____
	S _____	_____
	T _____ R _____	_____
3. Miscellaneous	S _____	_____
	T _____ R _____	_____
Property in Sec.	S _____	_____
	T _____ R _____	_____

**SURVEY &  
REMONUMENTATION**

MAR 13 2000

**SECTION**

4. Lot No. \_\_\_\_\_, Recorded Plat \_\_\_\_\_  
5. Private Claims \_\_\_\_\_

I, EDWARD W. REED, in a field survey on JULY 14, 19 98 do hereby state that under requirements of P.A. 74, Michigan P.A. of 1970, the corner points mentioned in lines 1 and 2 above were in conformance with regulations and rules therefore as required in the current manual of survey instructions of the United States Department of the Interior, Bureau of Land Management or by a decree of a Court of Law and /or that the corner points mentioned in lines 3, 4 and 5 above were in conformance with the rules of the Michigan Board of Land Surveyors or by a Decree of a Court of Law; established, re-established, monumented, recovered, found as expressed below:

**NOTE: Not more than 2 corners, all in the same town and range, may be recorded on this certificate.**

CORNER COMMON TO SECTION 6, BUTLER TWP., BRANCH COUNTY,  
SECTION 1, GIRARD TWP., BRANCH COUNTY  
SECTION 36, TEKONSHA TWP., CALHOUN COUNTY  
SECTION 31, CLARENDON TWP., CALHOUN COUNTY

A. Description of original monument and accessories and/or subsequent restoration:

1825: WM. BROOKFIELD, DEPT. SURVEYOR - CORNER SET  
1907: CHAS. HAMILTON, CO SURVEYOR - FOUND DRAIN TILE FILLED WITH COAL UNDER BIG STONE  
1977: E. R. REED, CO SURVEYOR - FOUND TILE FILLED WITH COAL, IRON "KETTLE", BROKEN GREEN GLASS, & BROKEN BRICK, BUT NO STONE, RECORDED IN LCRC # 198, SET 3/4" IRON ROD WITH RLS CAP THRU IRON & TILE

B. Description of corner evidence found and/or method applied in restoring or reestablishing corner:

FOUND 3/4" X 18 CAPPED IRON WITH GLASS, BRICK AND TILE

C. Description of monument for corner and accessories established to perpetuate locating the position of the corner:

SET 1/2" X 18" REBAR IRON WITH REMON CAP IN CI-MONUMENT BOX 4" BELOW GRAVEL ROAD SURFACE


TEL PED	N 76 E	87.7'
2" CEDAR	S 11 E	102.5'
22" CHERRY TREE	S 65 E	85.8' TO CENTER
2" X 2" ANGLE IRON POST	N 27 E	30.7' TO FACE
ROAD NAME SIGN	S 29 E	41.6' TO FACE

AND IS ACCEPTED AS A CAREFUL AND FAITHFUL PERPETUATION OF THE POSITION OF THE ORIGINAL CORNER.

Signed by Edward W. Reed  
EDWARD W. REED

Date NOV. 4, 1998

Surveyor's Michigan License No. 33985

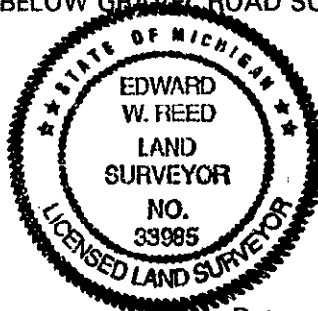

	A	B	C	D	E	F	G	H	I	J	K	L	M
1													
2	6		5		4		3		2		1		
3													
4	7		8		9		10		11		12		
5													
6	18		17		16		15		14		13		
7													
8	19		20		21		22		23		24		
9													
10	30		29		28		27		26		25		
11													
12	31		32		33		34		35		36		
13													