

APPROVED

STATE OF MICHIGAN
CALHOUN COUNTY
RECORDED

Date 10-29-98 RRC
CALHOUN COUNTY
REMONUMENTATION.

CALHOUN COUNTY REMONUMENTATION
LAND CORNER RECORDATION CERTIFICATE
Filing Requirement of Act 74, Mich. P.A. 1970

29 OCT 1998 2:40:27 PM

ANNE B. NORLANDER
CLERK - REGISTER OF DEEDS

LIBER 2073 PAGE 281

Register of Deeds Stamp & File Number

For corners in

Calhoun (County)	Located In:	Cornor Code #
Burlington Township		
1. Public Land Survey	T <u>4 S</u> R <u>7 W</u>	<u>C-3</u>
	T ___ R ___	_____
	T ___ R ___	_____
	T ___ R ___	_____
2. Property Controlling in Section	S ___ T ___ R ___	_____
	S ___ T ___ R ___	_____
3. Miscellaneous Property in Sec.	S ___ T ___ R ___	_____
	S ___ T ___ R ___	_____

4. Lot No. _____, Recorded Plat _____
5. Private Claims _____

I, William K. Crane, in a field survey on October 17, 1998 do hereby state that under requirements of P.A. 74, Michigan P.A. of 1970, the corner points mentioned in lines 1 and 2 above were in conformance with regulations and rules therefore as required in the current manual of survey instructions of the United States Department of the Interior, Bureau of Land Management or by a decree of a Court of Law and /or that the corner points mentioned in lines 3, 4 and 5 above were in conformance with the rules of the Michigan Board of Land Surveyors or by a Decree of a Court of Law, established, re-established, monumented, recovered, found as expressed below:

NOTE: Not more than 2 corners, all in the same town and range, may be recorded on this certificate.

1	A	B	C	D	E	F	G	H	I	J	K	L	I
2		6		5		4		3		2		1	
3			●										
4		7		8		9		10		11		12	
5													
6		18		17		16		15		14		13	
7													
8		19		20		21		22		23		24	
9													
10		30		29		28		27		26		25	
11													
12		31		32		33		34		35		36	
13													

A. Description of original monument and accessories and/or subsequent restoration:

G.L.O., Robert Clark, 1826:
13" Burr Oak N 1-1/2° E 149 links
16" W. Oak S 80° E 151 links

H.K. Whitney, 1094:
32" R.O.S. S 25° E 67' 8"
12" Maple S 25° 35' W 53' 3"
6" Maple S 81° W 24'

Don Davis, 1972:
Railroad spike
Corner post S 45° E 43.6'
Pump N 30° E 67.3'
14" Maple N 75° E 83.42'
R.R. Rail N 35° W 69.51'
Tele station S 40° W 53.7'

Carr, 7/92:
Found railroad spike per Davis notes
Utility pole N 55° E 51.05'
Corner post S 50° E 43.75'
30" Cherry S 50° W 47.56'

SURVEY &
REMONUMENTATION

MAR 30 1999

SECTION

Ryan, 12/92:
Found railroad spike
6" Maple N 50° W 87.57'
Utility pole N 50° E 51.04'
36" Cherry S 45° W 47.44'
Corner post S 45° E 43.80'


B. Description of corner evidence found and/or method applied in restoring or reestablishing corner:

Found railroad spike as referenced above. Replaced with Bemtsen monument and monument box.

C. Description of monument for corner and accessories established to perpetuate locating the position of the corner:

Set standard Calhoun County Remonumentation monument (Bemtsen monument) with monument box and is accepted as the best available evidence of the position of the original corner.

6" Maple N 50° W 87.57'
Utility Pole N 50° E 51.04'
36" Cherry S 45° W 47.44'
Steel fence post S 45° E 43.80'

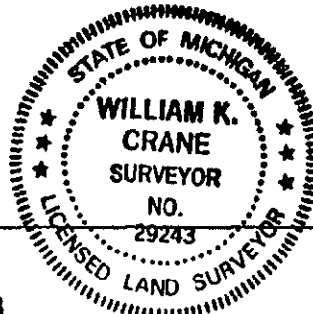

Signed by William K. Crane
William K. Crane, P.S.

Date 10/23/98

Surveyor's Michigan License No. 29243