

APPROVED

Date 12-9-98 RRL  
CALHOUN COUNTY  
REMONUMENTATION.

CALHOUN COUNTY REMONUMENTATION  
LAND CORNER RECORDATION CERTIFICATE  
Filing Requirement of Act 74, Mich. P.A. 1970

STATE OF MICHIGAN  
CALHOUN COUNTY  
RECORDED

For corners in

Calhoun  
(County)  
Burlington Township  
1. Public Land Survey

Located In:

Corner Code #

T 4 S R 7 W

C-5

T     R    

T     R    

T     R    

S     T     R    

S     T     R    

S     T     R    

S     T     R    

- 2. Property Controlling in Section
- 3. Miscellaneous Property in Sec.

4. Lot No. \_\_\_\_\_, Recorded Plat \_\_\_\_\_

5. Private Claims \_\_\_\_\_

15 DEC 1998 3:35:01 PM

ANNE B. NORLANDER  
CLERK - REGISTER OF DEEDS

LIBER **2087** PAGE **929**

Register of Deeds Stamp & File Number

I, William K. Crane, in a field survey on December 2, 1998 do hereby state that under requirements of P.A. 74, Michigan P.A. of 1970, the corner points mentioned in lines 1 and 2 above were in conformance with regulations and rules therefore as required in the current manual of survey instructions of the United States Department of the Interior, Bureau of Land Management or by a decree of a Court of Law and for that the corner points mentioned in lines 3, 4 and 5 above were in conformance with the rules of the Michigan Board of Land Surveyors or by a Decree of a Court of Law; established, re-established, monumented, recovered, found as expressed below:

NOTE: Not more than 2 corners, all in the same town and range, may be recorded on this certificate.

A. Description of original monument and accessories and/or subsequent restoration:

GLO Robert Clark, 1826:

14" W. Oak S 58° E 27 links  
15" W. Oak N 29½° W 39 links

Davis, no date (T.P.J.):

5/8" iron 0.5' East of centerline 45.00'  
12" Oak S 35° E 59.90'  
24" Maple N 35° E 59.90'  
Angle post West 25.04'

King, 1986 (T. Gordier):

Found iron in line with fence and tree row.

B. Description of corner evidence found and/or method applied in restoring or reestablishing corner:

Found iron as described by Davis and King, 0.5' East of centerline of Seven Mile Road and in line with fence rows East and West.


C. Description of monument for corner and accessories established to perpetuate locating the position of the corner:

Replaced iron with standard Calhoun County Remonumentation monument (Berntsen monument with monument box) and is accepted as the best available evidence of the position of the original corner.

Nail and tag in 10" Twin oak S 20° W 52.00'  
Nail and tag in 30" Oak S 20° E 44.91'  
Nail and tag in 12" Walnut East 48.60'  
Angle iron fence post West 25.20'

Signed by William K. Crane  
William K. Crane, P.S.  
Surveyor's Michigan License No. 29243

Date December 9, 1998

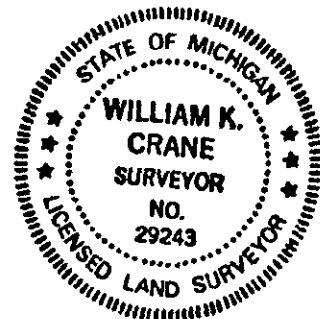

1	A	B	C	D	E	F	G	H	I	J	K	L	M
2	6		5		4		3		2		1		
3													
4	7		8		9		10		11		12		
5													
6	16		17		16		15		14		13		
7													
8	19		20		21		22		23		24		
9													
10	30		29		28		27		26		25		
11													
12	31		32		33		34		35		36		
13													

SUPPLEMENTAL  
REMONUMENTATION

MAR 30 1999

SECTION