

**SURVEY &
REMONUMENTATION**

MAR 13 2000

SECTION

**CALHOUN COUNTY REMONUMENTATION
LAND CORNER RECORDATION CERTIFICATE**
Filing Requirement of Act 74, Mich. P.A. 1970

STATE OF MICHIGAN
CALHOUN COUNTY
RECORDED

14 JUN 1999 1:56:41 PM

APPROVED

Date 5-19-99 *ARC*
**CALHOUN COUNTY
REMONUMENTATION.**

For corners in

<u>Calhoun</u> (County)	Located In:	Corner Code #
Burlington Township	T ___ R ___	_____
1. Public Land Survey	T ___ R ___	_____
	T ___ R ___	_____
	T ___ R ___	_____
2. Property Controlling in Section	S <u>8</u> T <u>4S</u> R <u>7W</u>	<u>D-4</u>
	S ___ T ___ R ___	_____
3. Miscellaneous Property in Sec.	S ___ T ___ R ___	_____
	S ___ T ___ R ___	_____

ANNE B. NORLANDER
CLERK - REGISTER OF DEEDS
LIBER 2134 PAGE 493

Register of Deeds Stamp & File Number

4. Lot No. _____, Recorded Plat _____
5. Private Claims _____

I, William K. Crane, in a field survey on April 20, 1999 do hereby state that under requirements of P.A. 74, Michigan P.A. of 1970, the corner points mentioned in lines 1 and 2 above were in conformance with regulations and rules therefore as required in the current manual of survey instructions of the United States Department of the Interior, Bureau of Land Management or by a decree of a Court of Law and /or that the corner points mentioned in lines 3, 4 and 5 above were in conformance with the rules of the Michigan Board of Land Surveyors or by a Decree of a Court of Law; established, re-established, monumented, recovered, found as expressed below:

NOTE: Not more than 2 corners, all in the same town and range, may be recorded on this certificate.

1	A	B	C	D	E	F	G	H	I	J	K	L	M
2		6		5		4		3		2		1	
3													
4		7		●		9		10		11		12	
5													
6		18		17		16		15		14		13	
7													
8		19		20		21		22		23		24	
9													
10		30		29		28		27		26		25	
11													
12		31		32		33		34		35		36	
13													

A. Description of original monument and accessories and/or subsequent restoration:

Center of Section 8. Point not set as part of the original government survey.


B. Description of corner evidence found and/or method applied in restoring or reestablishing corner:

Intersected North and South 1/4 line with East and West 1/4 line. Set Harrison monument in gravel road.

C. Description of monument for corner and accessories established to perpetuate locating the position of the corner:

Set standard Calhoun County Remonumentation monument (Harrison monument):

Set nail and tag in 60" White Oak	N 85°E	134.50'
Set nail and tag in 30" Twin White Oak	S 70° E	57.24'
Set nail and tag in 14" Cherry	N 30° W	36.79'
Set nail and tag in 12" Twin Red Oak	S 75° W	64.89'

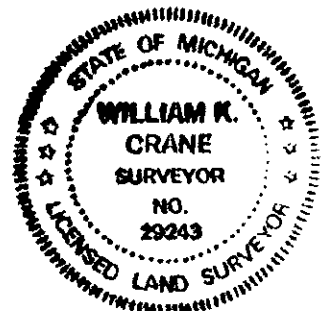

Signed by William K. Crane
William K. Crane, P.S.

Date 5/19/99

Surveyor's Michigan License No. 29243