

MAR 30 1999

APPROVED

SECTION

Date 12-9-98 RRC
CALHOUN COUNTY
REMONUMENTATION.

**CALHOUN COUNTY REMONUMENTATION
LAND CORNER RECORDATION CERTIFICATE**
Filing Requirement of Act 74, Mich. P.A. 1970

STATE OF MICHIGAN
CALHOUN COUNTY
RECORDED

For corners in

Calhoun _____ (County)	Located In:	Corner Code #
Burlington Township	T <u>4 S</u> R <u>7 W</u>	<u>E-4</u>
1. Public Land Survey	T _____ R _____	_____
	T _____ R _____	_____
	T _____ R _____	_____
2. Property Controlling in Section	S _____ T _____ R _____	_____
	S _____ T _____ R _____	_____
3. Miscellaneous Property in Sec.	S _____ T _____ R _____	_____
	S _____ T _____ R _____	_____

15 DEC 1998 3:34:15 PM

ANNE B. NORLANDER
CLERK - REGISTER OF DEEDS


LIBER **2087** PAGE **925**

Register of Deeds Stamp & File Number

4. Lot No. _____, Recorded Plat _____
5. Private Claims _____

I, William K. Crane, in a field survey on November 30, 1998, do hereby state that under requirements of P.A. 74, Michigan P.A. of 1970, the corner points mentioned in lines 1 and 2 above were in conformance with regulations and rules therefore as required in the current manual of survey instructions of the United States Department of the Interior, Bureau of Land Management or by a decree of a Court of Law and /or that the corner points mentioned in lines 3, 4 and 5 above were in conformance with the rules of the Michigan Board of Land Surveyors or by a Decree of a Court of Law; established, re-established, monumented, recovered, found as expressed below:

NOTE: Not more than 2 corners, all in the same town and range, may be recorded on this certificate.

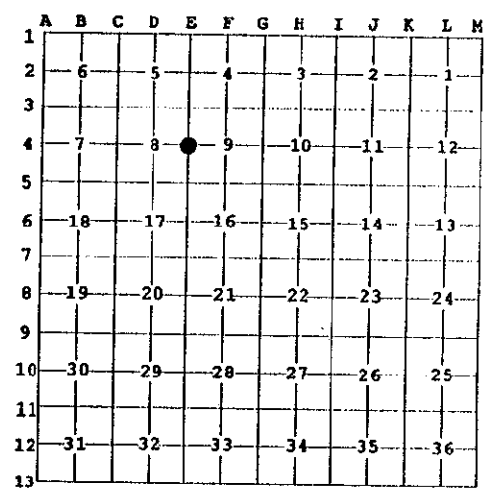

A. Description of original monument and accessories and/or subsequent restoration:

GLO Robert Clark, 1826:
6" Tamarack S 2° W 3½ links
6" D. O. N 2° E 2½ links

Crane, 1995:
Set ½" iron with cap #29243 at intersection of fences North, South, East & West
12" Maple N 80° E 11.46'
12" Ash N 20° W 14.11'
10" Elm S 45° W 25.57'
14" Elm S 30° E 25.25'

B. Description of corner evidence found and/or method applied in restoring or reestablishing corner:

Found capped iron rod as set in 1995.

C. Description of monument for corner and accessories established to perpetuate locating the position of the corner:

Replaced capped iron with standard Calhoun County Remonumentation monument (Berntsen monument with Carsonite marker) and is accepted as the best available evidence of the position of the original corner.
Found nail in 12" Maple N 80° E 11.46'
Found nail in 12" Ash N 20° W 14.11'
Found nail in 10" Elm S 45° W 25.57'
Found nail in 14" Elm S 30° E 25.25'

Signed by William K. Crane
William K. Crane, P.S.

Date December 9, 1998

Surveyor's Michigan License No. 29243

