

MAR 30 1999

SECTION

STATE OF MICHIGAN  
CALHOUN COUNTY  
RECORDED

15 DEC 1998 3:34:50 PM

ANNE B. NORLANDER  
CLERK - REGISTER OF DEEDS

LIBER 2087 PAGE 928

Register of Deeds Stamp & File Number

**APPROVED**

Date 12-9-98 KKC  
**CALHOUN COUNTY  
REMONUMENTATION.**

**CALHOUN COUNTY REMONUMENTATION  
LAND CORNER RECORDATION CERTIFICATE  
Filing Requirement of Act 74, Mich. P.A. 1970**


For corners in

<u>Calhoun</u> (County)	Located In:	Corner Code #
Burlington Township		
1. Public Land Survey	T <u>4 S</u> R <u>7 W</u>	<u>E-5</u>
	T ___ R ___	_____
	T ___ R ___	_____
	T ___ R ___	_____
2. Property Controlling in Section	S ___ T ___ R ___	_____
	S ___ T ___ R ___	_____
3. Miscellaneous Property in Sec.	S ___ T ___ R ___	_____
	S ___ T ___ R ___	_____

4. Lot No. \_\_\_\_\_, Recorded Plat \_\_\_\_\_  
5. Private Claims \_\_\_\_\_

I, William K. Crane, in a field survey on December 2, 1998, do hereby state that under requirements of P.A. 74, Michigan P.A. of 1970, the corner points mentioned in lines 1 and 2 above were in conformance with regulations and rules therefore as required in the current manual of survey instructions of the United States Department of the Interior, Bureau of Land Management or by a decree of a Court of Law and for that the corner points mentioned in lines 3, 4 and 5 above were in conformance with the rules of the Michigan Board of Land Surveyors or by a Decree of a Court of Law; established, re-established, monumented, recovered, found as expressed below:

**NOTE: Not more than 2 corners, all in the same town and range, may be recorded on this certificate.**

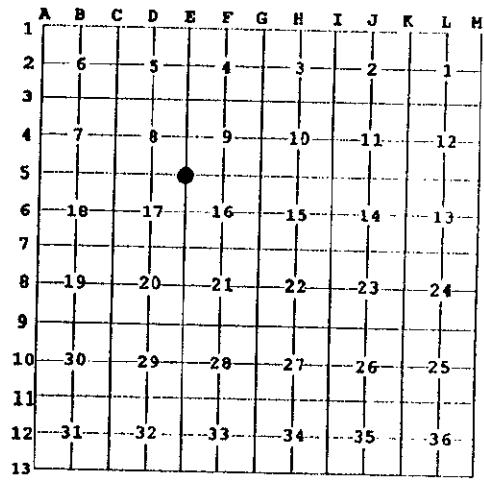

A. Description of original monument and accessories and/or subsequent restoration:

GLO Robert Clark, 1826:  
12" W. ash N 82° W 23 links  
12" D. O. N 41° E 14 links

A. H. Chase, 1935:  
Dug at proportional measurement which came 69 links East of fence and found at 73 links mark of stake in white sand under muck. Set concrete monument with iron stake.  
Soft maple S 20° E 39-3/4 links  
Crooked elm S 40° W 53 1/2 links  
Maple N 34 1/2° E 43 1/2 links

B. Description of corner evidence found and/or method applied in restoring or reestablishing corner:

Found octagonal concrete monument 3 feet long with 1/2" ID iron pipe, in East and West fence and 48.3 feet East of fence to the North.

C. Description of monument for corner and accessories established to perpetuate locating the position of the corner:

Replaced octagonal concrete monument with standard Calhoun County Remonumentation monument (Berntsen monument with Carsonite marker) and is accepted as the best available evidence of the position of the original corner.  
8" x 8" RR tie fence post West 48.30'  
Nail and tag in 12" Elm N 80° E 47.10'  
Nail and tag in 14" Walnut N 10° W 56.30'  
Nail and tag in 14" Oak S 5° E 28.27'

Signed by William K. Crane  
William K. Crane, P.S.  
Surveyor's Michigan License No. 29243

Date December 9, 1998

