

APPROVED

Date 10-29-98 JRC
CALHOUN COUNTY
REMONUMENTATION

CALHOUN COUNTY REMONUMENTATION
LAND CORNER RECORDATION CERTIFICATE
Filing Requirement of Act 74, Mich. P.A. 1970

STATE OF MICHIGAN
TERRITORIAL CORNERS
RECORDED

29 OCT 1998 2:40:38 PM

For corners in

Calhoun (County)	Located In:	Corner Code #
Burlington Township		
1. Public Land Survey	T 4 S R 7 W	F-3
	T R	
	T R	
	T R	
2. Property Controlling in Section	S T R	
	S T R	
3. Miscellaneous Property in Sec.	S T R	
	S T R	

APRIL B. NORLWAGEN
CLERK - REGISTER OF DEEDS
LIBER 2073 PAGE 282
Register of Deeds Stamp & File Number

4. Lot No. _____, Recorded Plat _____
5. Private Claims _____

I, William K. Crane, in a field survey on October 17, 1998 do hereby state that under requirements of P.A. 74, Michigan P.A. of 1970, the corner points mentioned in lines 1 and 2 above were in conformance with regulations and rules therefore as required in the current manual of survey instructions of the United States Department of the Interior, Bureau of Land Management or by a decree of a Court of Law and for that the corner points mentioned in lines 3, 4 and 5 above were in conformance with the rules of the Michigan Board of Land Surveyors or by a Decree of a Court of Law; established, re-established, monumented, recovered, found as expressed below:

NOTE: Not more than 2 corners, all in the same town and range, may be recorded on this certificate.

A	B	C	D	E	F	G	H	I	J	K	L	M
1												
2	6		5		4		3		2		1	
3					●							
4	7		8		9		10		11		12	
5												
6	18		17		16		15		14		13	
7												
8	19		20		21		22		23		24	
9												
10	30		29		28		27		26		25	
11												
12	31		32		33		34		35		36	
13												

A. Description of original monument and accessories and/or subsequent restoration:

G.L.O., Robert Clark, 1826:
18" Y. Oak N 8 W 51 links
13" D.O. S 22 W 109 links

Carr. 10/90:
Found railroad spike
Triple oak N 50 E 52.55
In line w/power poles N & S
Triple cherry S 70 E 96.10'
Utility pole South 29.0'
In centerline of road E & W

Crane, 12/12/95:
Found railroad spike
Power pole South 29.13'
SW corner house #3501 N 30° E 99.85'
20" triple oak N 60° E 54.47'
12" triple cherry S 70° E 96.20'

SURVEY &
REMONUMENTATION

MAR 30 1999

SECTION


B. Description of corner evidence found and/or method applied in restoring or reestablishing corner:

Found railroad spike as referenced above. Replaced with Berntsen monument and monument box.

C. Description of monument for corner and accessories established to perpetuate locating the position of the corner:

Set standard Calhoun County Remonumentation monument (Berntsen monument) with monument box and is accepted as the best available evidence of the position of the original corner.

16" triple oak N 45° E 54.93'
16" oak S 70° E 99.00'
Utility pole South 29.30'
38" oak N 65° W 109.50'
0.5' South of centerline bituminous road

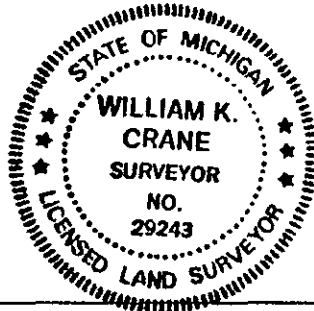

Signed by William K. Crane
William K. Crane, P.S.

Date 10/23/98

Surveyor's Michigan License No. 29243