

APPROVED

Date 10-29-98 RRL  
CALHOUN COUNTY  
REMONUMENTATION.

STATE OF MICHIGAN  
CALHOUN COUNTY  
RECORDED

CALHOUN COUNTY REMONUMENTATION  
LAND CORNER RECORDATION CERTIFICATE  
Filing Requirement of Act 74, Mich. P.A. 1970

29 OCT 1998 2:40:50 PM

For corners in

<u>Calhoun</u> (County)	Located In:	Corner Code #
Burlington Township	T <u>4 S</u> R <u>7 W</u>	<u>F-5</u>
1. Public Land Survey	T _____ R _____	_____
	T _____ R _____	_____
2. Property Controlling in Section	S _____ T _____ R _____	_____
	S _____ T _____ R _____	_____
3. Miscellaneous Property in Sec.	S _____ T _____ R _____	_____
	S _____ T _____ R _____	_____

AGNE H. WOODRUFF  
CLERK - REGISTER OF DEEDS  
LIBER **2073** PAGE **283**

Register of Deeds Stamp & File Number

4. Lot No. \_\_\_\_\_, Recorded Plat \_\_\_\_\_  
5. Private Claims \_\_\_\_\_

I, William K. Crane, in a field survey on October 3, 1998 do hereby state that under requirements of P.A. 74, Michigan P.A. of 1970, the corner points mentioned in lines 1 and 2 above were in conformance with regulations and rules therefore as required in the current manual of survey instructions of the United States Department of the Interior, Bureau of Land Management or by a decree of a Court of Law and/or that the corner points mentioned in lines 3, 4 and 5 above were in conformance with the rules of the Michigan Board of Land Surveyors or by a Decree of a Court of Law; established, re-established, monumented, recovered, found as expressed below:

NOTE: Not more than 2 corners, all in the same town and range, may be recorded on this certificate.

A	B	C	D	E	F	G	H	I	J	K	L	M
1												
2	6		5		4		3		2		1	
3												
4	7		8		9		10		11		12	
5												
6	18		17		16		15		14		13	
7												
8	19		20		21		22		23		24	
9												
10	30		29		28		27		26		25	
11												
12	31		32		33		34		35		36	
13												

A. Description of original monument and accessories and/or subsequent restoration:

G.L.O., Robert Clark, 1826:  
5" Beech N 75 E 15-1/2 links  
24" D.O. S 10 E 12-1/2 links

B. J. Wells, County Surveyor, 1878:  
24" x 13" x 8" Stone  
5" Maple N 28° W 100 links

Crane, 1995:

Set 1/2" capped rodd (#29243) on line from S 1/4 Corner of Sec 16, thru center of Section at intersection with fences East and West. 2' East centerline of gravel road. Dug 2.5' deep hole 6' x 10' looking for Wells stone, but could not find.

Guy pole East 19.60'  
Power Pole West 30.68'  
NE Corner of house S 80° W 112.17'  
6" Pine S 20° W 101.84'

SURVEY &  
REMONUMENTATION

MAR 30 1999

B. Description of corner evidence found and/or method applied in restoring or reestablishing corner:


Found 1/2" capped rodd as established in 1995. Replaced iron with Harrison monument.

SECTION

C. Description of monument for corner and accessories established to perpetuate locating the position of the corner:

Set standard Calhoun County Remonumentation monument (Harrison monument) with monument box and is accepted as the best available evidence of the position of the original corner.

Guy pole East 19.65'  
Power pole West 30.68'  
NE Corner of house S 80° W 112.17'  
4" Maple N 30° E 61.00'

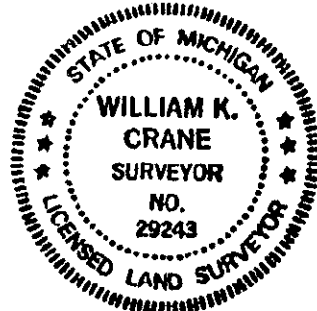

Signed by William K. Crane

Date 10/23/98

William K. Crane, P.S.

Surveyor's Michigan License No. 29243