

APPROVED

Date 10-29-98 PRC
CALHOUN COUNTY
REMONUMENTATION.

CALHOUN COUNTY REMONUMENTATION
LAND CORNER RECORDATION CERTIFICATE
 Filing Requirement of Act 74, Mich. P.A. 1970

STATE OF MICHIGAN
 CALHOUN COUNTY
 RECORDED

29 OCT 1998 2:40:14 PM

For corners in

<u>Calhoun</u>	Located In:	Cornor Code #
(County)		
Burlington Township		
1. Public Land Survey	<u>T 4 S R 7 W</u>	<u>F-6</u>
	T ___ R ___	_____
	T ___ R ___	_____
	T ___ R ___	_____
2. Property Controlling	S ___ T ___ R ___	_____
in Section	S ___ T ___ R ___	_____
3. Miscellaneous	S ___ T ___ R ___	_____
Property in Sec.	S ___ T ___ R ___	_____

ANNE D. NORLANDER
 CLERK - REGISTER OF DEEDS
 LIBER **2073** PAGE **280**
Register of Deeds Stamp & File Number

4. Lot No. _____, Recorded Plat _____
 5. Private Claims _____

I, William K. Crane, in a field survey on October 3, 1998 do hereby state that under requirements of P.A. 74, Michigan P.A. of 1970, the corner points mentioned in lines 1 and 2 above were in conformance with regulations and rules therefore as required in the current manual of survey instructions of the United States Department of the Interior, Bureau of Land Management or by a decree of a Court of Law and for that the corner points mentioned in lines 3, 4 and 5 above were in conformance with the rules of the Michigan Board of Land Surveyors or by a Decree of a Court of Law; established, re-established, monumented, recovered, found as expressed below:

NOTE: Not more than 2 corners, all in the same town and range, may be recorded on this certificate.

A	B	C	D	E	F	G	H	I	J	K	L	M
1												
2	6		5		4		3		2		1	
3												
4	7		8		9		10		11		12	
5												
6	18		17		16		15		14		13	
7												
8	19		20		21		22		23		24	
9												
10	30		29		28		27		26		25	
11												
12	31		32		33		34		35		36	
13												

A. Description of original monument and accessories and/or subsequent restoration:

B. F. Wells, County Surveyor, 1878:
 Ran 1/4 lines placed 8" diameter stone at their intersection

Chase, 1935:
 Set hexagonal concrete monument at stone set by Wells

Crane, 3/24/88:
 Found hexagonal concrete monument set by Chase raised with capped iron.
 Power pole N 60° E 64.02'
 Power pole S 45° W 40.76'
 West end 12" C.M.P. N 45° W 42.93'
 East end 12" C.M.P. N 30° E 37.0'
 Buried tele cable pedestal, centerline S 45° E 23.78'
 Steel bar on E & W 1/4 line East 73.19'

Greer, 8/88:
 Found 1/2" rerod
 Power pole N 60° E 64.02'
 Power pole S 45° W 40.76'
 West end C.M.P. N 45° W 42.93'
 East end C.M.P. N 30° E 37.00'
 Tele Pedestal S 45° E 23.78'

RECEIVED
 MAR 30 1999

B. Description of corner evidence found and/or method applied in restoring or reestablishing corner:


Found 1/2" rerod over hexagonal concrete monument. Replaced iron and monument with Harrison monument.

SECTION

C. Description of monument for corner and accessories established to perpetuate locating the position of the corner:

Set standard Calhoun County Remonumentation monument (Harrison monument). This position not established by original government surveyors.

Utility pole S 35° E 28.12'
 Utility pole S 45° W 40.76'
 20" Oak S 75° W 115.00'
 West end 12" culvert N 45° W 43'

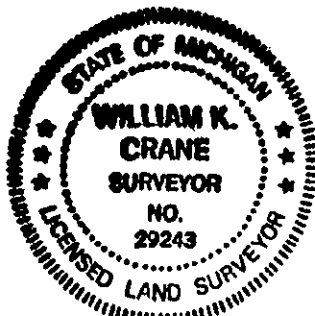

Signed by William K. Crane

Date 10/23/98

William K. Crane, P.S.

Surveyor's Michigan License No. 29243