

APPROVED

Date 10-29-98 *RKC*

CALHOUN COUNTY REGISTERED

STATE L. ... DAN  
CALHOUN COUNTY  
RECORDED

29 OCT 1998 2:40:02 PM

ANNE B. MORLANDER  
CLERK - REGISTER OF DEEDS

**CALHOUN COUNTY REMONUMENTATION  
LAND CORNER RECORDATION CERTIFICATE**  
Filing Requirement of Act 74, Mich. P.A. 1970

LIBER **2073** PAGE **279**

For corners in

<u>Calhoun</u> (County)	Located In:	Corner Code #
Burlington Township		
1. Public Land Survey	<u>T 4 S R 7 W</u>	<u>G-3</u>
	T ___ R ___	_____
	T ___ R ___	_____
	T ___ R ___	_____
2. Property Controlling in Section	S ___ T ___ R ___	_____
	S ___ T ___ R ___	_____
3. Miscellaneous Property in Sec.	S ___ T ___ R ___	_____
	S ___ T ___ R ___	_____

Register of Deeds Stamp & File Number

4. Lot No. \_\_\_\_\_, Recorded Plat \_\_\_\_\_  
5. Private Claims \_\_\_\_\_

I, William K. Crane, in a field survey on October 17, 1998 do hereby state that under requirements of P.A. 74, Michigan P.A. of 1970, the corner points mentioned in lines 1 and 2 above were in conformance with regulations and rules therefore as required in the current manual of survey instructions of the United States Department of the Interior, Bureau of Land Management or by a decree of a Court of Law and /or that the corner points mentioned in lines 3, 4 and 5 above were in conformance with the rules of the Michigan Board of Land Surveyors or by a Decree of a Court of Law; established, re-established, monumented, recovered, found as expressed below.

NOTE: Not more than 2 corners, all in the same town and range, may be recorded on this certificate.

A	B	C	D	E	F	G	H	I	J	K	L	M
1												
2	6	5	4	3	2	1						
3												
4	7	8	9	10	11	12						
5												
6	18	17	16	15	14	13						
7												
8	19	20	21	22	23	24						
9												
10	30	29	28	27	26	25						
11												
12	31	32	33	34	35	36						
13												

A. Description of original monument and accessories and/or subsequent restoration:

G.L.O., Robert Clark, 1826:  
18" Y. Oak S 29° E 32-1/2 links  
16" W. Oak N 55° W 48-1/2 links

Carr. 10/90:  
1/2" iron in monument  
4' North of centerline of E & W road in centerline road to North  
2' East of centerline road to South  
P.K. in utility pole S 65° W 98.92'  
P.K. in utility pole S 30° E 107.18'  
20" Oak N 70° E 91.30'  
18" Maple N 65° W 53.72'

J. Bush, Cal. Co. Rd. Comm. 1979:  
Iron bar in monument box  
56" Oak N 27° W 64.47'  
14" Maple N 60° W 54.39'  
Power pole S 60° W 97.38'

Crane, 12/12/95:  
Found 1/2" iron in monument box  
Power pole S 20° E 107.22'  
20" Maple N 45° E 45.03'  
20" Maple N 60° W 54.57'  
Power pole S 78° W 97.20'

SURVEY & RE-MONUMENTATION

MAR 30 1999

SECTION


B. Description of corner evidence found and/or method applied in restoring or reestablishing corner:

Found 1/2" iron and monument box as referenced above. Replaced 1/2" iron and monument with Berntsen monument and reset monument box.

C. Description of monument for corner and accessories established to perpetuate locating the position of the corner:

Set standard Calhoun County Remonumentation monument (Berntsen monument) in monument box and is accepted as the best available evidence of the position of the original corner.

30" Maple N 45° E 45.15'  
14" Maple S 45° E 77.12'  
Utility pole S 50° W 97.25'  
26" Maple N 60° W 54.60'  
3.7' North of centerline of N Drive South

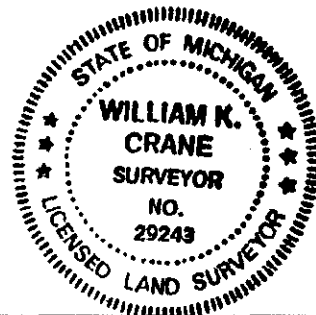

Signed by William K. Crane

Date 10/23/98

William K. Crane, P.S.

Surveyor's Michigan License No. 29243