

SURVEY & REMONUMENTATION

MAR 2 1 1997

COMMISSION

APPROVED

Date Oct. 16 1996
**CALHOUN COUNTY
 REMONUMENTATION.**

**CALHOUN COUNTY REMONUMENTATION
 LAND CORNER RECORDATION CERTIFICATE**
 Filing Requirement of Act 74, Mich. P.A. 1970

STATE OF MICHIGAN
 CALHOUN COUNTY
 RECORDED

For corners in

Calhoun	Located In:	Corner Code #	
(County)			
Burlington Twp.			
1. Public Land Survey	T <u>4 S</u> R <u>7 W</u>	<u>1-7</u>	
	T ___ R ___	_____	
	T ___ R ___	_____	
	T ___ R ___	_____	
2. Property Controlling in Section	S ___ T ___ R ___	_____	
	S ___ T ___ R ___	_____	
3. Miscellaneous Property in Sec.	S ___ T ___ R ___	_____	
	S ___ T ___ R ___	_____	

18 OCT 96 2:34 P.M.

ANNE B. NORLANDER
 CLERK - REGISTER OF DEEDS

LIBER **1893** PAGE **313**

Register of Deeds Stamp & File Number

4. Lot No. _____, Recorded Plat _____
 5. Private Claims _____

	A	B	C	D	E	F	G	H	I	J	K	L	M
1													
2		6		5		4		3		2		1	
3													
4		7		8		9		10		11		12	
5													
6		18		17		16		15		14		13	
7									⊙				
8		19		20		21		22		23		24	
9													
10		30		29		28		27		26		25	
11													
12		31		32		33		34		35		36	
13													

I, Michael A. Groat, in a field survey on September 12, 1996 do hereby state that under requirements of P.A. 74, Michigan P.A. of 1970, the corner points mentioned in lines 1 and 2 above were in conformance with regulations and rules therefore as required by the current manual of survey instructions of the United States Department of the Interior, Bureau of Land Management or by a decree of a Court of Law and for that the corner points mentioned in lines 3, 4 and 5 above were in conformance with the rules of the Michigan Board of Land Surveyors or by a Decree of a Court of Law; established, re-established, monumented, recovered, found as expressed below.

NOTE: Not more than 2 corners, all in the same town and range, may be recorded on this certificate.

A. Description of original monument and accessories and/or subsequent restoration:

Original Survey, Clark, Deputy Surveyor, 1825, Set post, Beech 8" S 74° W, 21 links Beech, 13", N 71° E 14 links

A. H. Chase, 1935, set a concrete monument, 8" Hickory, SE, 133.5'; 6" Elm, SW, 54.9'; 6" Elm NW 41.3'; 10" B. O. NE 146.5'

B. Description of corner evidence found and/or method applied in restoring or reestablishing corner:

Found a Jim Miller (P.S. # 27456) capped iron next to a concrete monument, checked into A.H. Chase witness from 1935. Accepted as the position of the corner set by A.H. Chase in 1935.


C. Description of monument for corner and accessories established to perpetuate locating the position of the corner:

Set Berntsen monument with Section information and P.S. # 39079 stamped in the brass cap. Placed a carsonite marker beside.

Witnesses:

- 314° NAZ, Nail and Spotter in 10" Elm, 39.42'
- 25° NAZ, Nail and Spotter in 14" Oak, 23.75'
- 223° NAZ, Nail And Spotter in 12" Elm, 22.10'
- 104° NAZ, Nail And Spotter in 6" Elm, 35.66'

NAZ = Azimuth measured from magnetic North

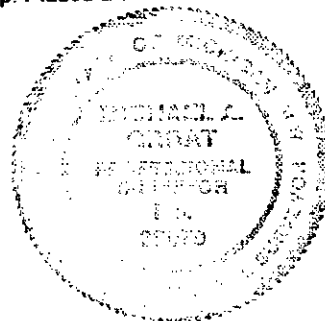

Signed by Michael A. Groat
 Michael A. Groat
 Surveyor's Michigan License No. 39079

Date 9-30-96