

APPROVED

Date 11-12-96

CALHOUN COUNTY
REMONUMENTATION.

SURVEY &
REMONUMENTATION

CALHOUN COUNTY REMONUMENTATION
LAND CORNER RECORDATION CERTIFICATE
Filing Requirement of Act 74, Mich. P.A. 1970

STATE OF MICHIGAN
CALHOUN COUNTY
RECORDED

19 NOV 96 2:02 P.M.

ANNE B. NORLANDER
CLERK - REGISTER OF DEEDS

LIBER 1899 PAGE 624

For corners in

<u>CALHOUN</u> (County)	Located In:	Corner Code #
BURLINGTON TWP.	T. <u>4S</u> R. <u>7W</u>	<u>M-8</u>
1. Public Land Survey	T. _____ R. _____	_____
	T. _____ R. _____	_____
	T. _____ R. _____	_____
2. Property Controlling in Section	S. _____ T. _____ R. _____	_____
	S. _____ T. _____ R. _____	_____
3. Miscellaneous Property in Sec.	S. _____ T. _____ R. _____	_____
	S. _____ T. _____ R. _____	_____

SURVEY &
REMONUMENTATION

Register of Deeds Stamp & File Number

MAR 21 1997

4. Lot No. _____, Recorded Plat _____
5. Private Claims _____

COMMISSION

I, MICHAEL A GROAT, in a field survey on NOVEMBER 6, 1996 do hereby state that under requirements of P.A. 74, Michigan P.A. of 1970, the corner points mentioned in lines 1 and 2 above were in conformance with regulations and rules therefore as required in the current manual of survey instructions of the United States Department of the Interior, Bureau of Land Management or by a decree of a Court of Law and /or that the corner points mentioned in lines 3, 4 and 5 above were in conformance with the rules of the Michigan Board of Land Surveyors or by a Decree of a Court of Law; established, re-established, monumented, recovered, found as expressed below:

NOTE: Not more than 2 corners, all in the same town and range, may be recorded on this certificate.

1	A	B	C	D	E	F	G	H	I	J	K	L	M
2		6		5		4		3		2		1	
3													
4		7		8		9		10		11		12	
5													
6		18		17		16		15		14		13	
7													
8		19		20		21		22		23		24	
9													
10		30		29		28		27		26		25	
11													
12		31		32		33		34		35		36	
13													

A. Description of original monument and accessories and/or subsequent restoration:

ORIGINAL SURVEY IN 1826 BY ROBERT CLARK, DEPUTY SURVEYOR, SET POST 40 CHAINS EAST OF THE SOUTHWEST CORNER OF SECTION 1; B. OAK, 24° S 16° W, 42 LINKS; W. OAK, 8° N 50° W, 22 LINKS

JUNE OF 1935, A.H. CHASE, R.C.E., RE-SET THE CORNER (DOES NOT SAY WITH WHAT) 32.34 FEET SOUTH OF THE TEKONSHA CORNER, LEAVING 8 FEET OF SURPLUS IN THE NORTH 1/2 OF THE SECTION; 8" WALNUT, S 45° 2' 58 FEET; 36" ELM, S 11° E, 92.2'; 34 FEET SOUTH OF FENCE TO EAST.

B. Description of corner evidence found and/or method applied in restoring or reestablishing corner:

COULD NOT FIND THE WITNESS TREES NOTED BY CHASE. FOUND TEKONSHA CORNER AND FENCE TO EAST. MEASURED 32.34 FEET SOUTH ON THE SECTION LINE AND DUG BUT FOUND NOTHING. THE ROAD APPEARS TO HAVE BEEN CUT. MEASURED THE HALF MILE TO THE NORTH AND SOUTH FROM THIS LOCATION AND FOUND 8 FEET OF SURPLUS IN THE NORTHERN HALF. ACCEPTED THIS AS THE BEST LOCATION FOR THIS CORNER.


C. Description of monument for corner and accessories established to perpetuate locating the position of the corner:

SET BERNTSEN MONUMENT IN A MONUMENT BOX. STAMPED SECTION INFORMATION AND P.S. #39079 IN BRASS CAP.

WITNESSES:
5' WEST OF CENTERLINE
32.34 FEET SOUTH OF TEKONSHA CORNER (1/2" IRON)
210° NAZ, NAIL AND TAG IN NORTHWESTERLY SIDE OF 10" COTTONWOOD, 56.45'
161° NAZ, NAIL AND TAG IN SOUTHWESTERLY SIDE OF 10" ASH, 85.1'
44° NAZ, NAIL AND TAG IN SOUTHEASTERLY SIDE OF 6" MAPLE, 60.73'
266° NAZ, NAIL AND TAG IN NORTHERLY SIDE OF 8" MAPLE, 27.85'

NAZ = AZIMUTH MEASURED FROM MAGNETIC NORTH

Signed by Michael A. Groat
Surveyor's Michigan License No. 39079

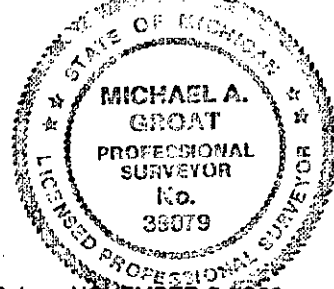

Date NOVEMBER 8, 1996