

**CALHOUN COUNTY REMONUMENTATION
LAND CORNER RECORDATION CERTIFICATE
Filing Requirement of Act 74, Mich. P.A. 1970**

APPROVED
Date July 22 1995
**CALHOUN COUNTY
REMONUMENTATION.**

For corners in
Calhoun
(County)
Burlington Twp.

	Located In:	Corner Code #
1. Public Land Survey	T <u>4S</u> R <u>7W</u>	<u>M-11</u>
	T _____ R _____	_____
	T _____ R _____	_____
	T _____ R _____	_____
2. Property Controlling in Section	S _____ T _____ R _____	_____
	S _____ T _____ R _____	_____
3. Miscellaneous Property in Section	S _____ T _____ R _____	_____
	S _____ T _____ R _____	_____
4. Lot No. _____, Recorded Plat _____		
5. Private Claims _____		

STATE OF MICHIGAN
CALHOUN COUNTY
RECORDED

22 SEP 95 10:03 A.M.

ANNE B. NORLANDER
Register of Deeds State of Michigan
CLERK REGISTER # _____

A	B	C	D	E	F	G	H	I	J	K	L	M
2	6		5		4		3		2		1	
3												
4	7		8		9		10		11		12	
5												
6	18		17		16		15		14		13	
7												
8	19		20		21		22		23		24	
9												
10	30		29		28		27		26		25	
11												
12	31		32		33		34		35		36	
13												

I, Michael A. Groat, in a field survey on July 3, 1995, do hereby certify that under requirements of P.A. 74, Michigan P.A. of 1970, the corner points mentioned in lines 1 and 2 above were in conformance with regulations and rules therefore as required in the current manual of survey instructions of the United States Department of the Interior, Bureau of Land Management or by a decree of a Court of Law and/or that the corner points mentioned in lines 3, 4 and 5 above were in conformance with the rules of the Michigan Board of Professional Surveyors or by a Decree of a Court of Law; established, re-established, monumented, re-monumented, recovered, found as expressed below:

NOTE: Not more than 4 corners, all in the same town and range, may be recorded on this certificate.

A. Description of original monument and accessories and/or subsequent restoration:

Lyon, 1825	Courtright, 1893
9" White Ash, S 34°W, 36 Links	3" tile
18" Black Ash, N 60°W, 16 links	7 Links North of Tekonsha cor.

A.H. Chase, 1935
Set a concrete monument beside the 3" tile
14" Hickory, S 68°E 68.3'
10" Walnut, S 25°W, 69.9'
6"Hickory, S 17°W, 74.1'

B. Description of corner evidence found and/or method applied in restoring or reestablishing corner:

Found concrete monument and 3" tile 4.8' North of Tekonsha corner. Measured to 14" hickory as referenced by A.H. Chase, no other witnesses remain. Accepted the tile as a good perpetuation of original monument.

REMONUMENTATION

LIBER 1822 PAGE 35


FEB 22 1996

COMMISSION

C. Description of monument for corner and accessories established to perpetuate locating the position of the corner:

Set a Harrison monument in the centerline of road, from which:

Nail and spotter in 24" hickory, S 65°E, 68.2' (old, Chase, 1935)
Nail and spotter in 30" Oak, N 40°E, 60.0'
Nail and spotter in 18" hickory, S 15°E, 118.9'
Nail and spotter in utility pole, N 10°E, 297.0'

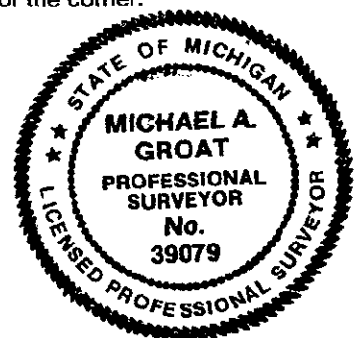

Signed by Michael A. Groat
Surveyor's Michigan License No. 39079

Date July 8, 1995