

APPROVED

Date 8-18-99 *RRC*

CALHOUN COUNTY REMONUMENTATION

CALHOUN COUNTY REMONUMENTATION LAND CORNER RECORDATION CERTIFICATE Filing Requirement of Act 74, Mich. P.A. 1970

STATE OF MICHIGAN CALHOUN COUNTY RECORDED

20 AUG 1999 1:24:01 PM

ANNE B. NORLANDER CLERK - REGISTER OF DEEDS

LIBER 2154 PAGE 420

Register of Deeds Stamp & File Number

CALHOUN	Located In:	Corner Code #
(County)		
ATHENS TOWNSHIP		
1. Public Land Survey	T <u>4S</u> R <u>8W</u>	<u>A-13</u>
	T _____ R _____	_____
	T _____ R _____	_____
	T _____ R _____	_____
2. Property Controlling in Section	S _____ T _____ R _____	_____
	S _____ T _____ R _____	_____
3. Miscellaneous Property in Sec.	S _____ T _____ R _____	_____
	S _____ T _____ R _____	_____

4. Lot No. _____, Recorded Plat _____
5. Private Claims _____

I, ROBERT R. CARR, in a field survey on JUNE 22, 1999 do hereby state that under requirements of P.A. 74, Michigan P.A. of 1970, the corner points mentioned in lines 1 and 2 above were in conformance with regulations and rules therefore as required in the current manual of survey instructions of the United States Department of the Interior, Bureau of Land Management or by a decree of a Court of Law and /or that the corner points mentioned in lines 3, 4 and 5 above were in conformance with the rules of the Michigan Board of Land Surveyors or by a Decree of a Court of Law; established, re-established, monumented, recovered, found as expressed below:

NOTE: Not more than 2 corners, all in the same town and range, may be recorded on this certificate.

	A	B	C	D	E	F	G	H	I	J	K	L	M
1													
2	6			5		4		3		2			1
3													
4	7			8		9		10		11			12
5													
6	18			17		16		15		14			13
7													
8	19			20		21		22		23			24
9													
10	30			29		28		27		26			25
11													
12	31			32		33		34		35			36
13													

A. Description of original monument and accessories and/or subsequent restoration:

G.L.O. CORNER SET BY JOHN MULLETT D.S. 1825.
RESURVEY BY F.A. COURTRIGHT 1896 FOUND LARGE STONE WITH DRILL HOLE IN TOP AND TOOK NEW WITNESSES.
D. DAVIS P.S. NO. 17617 1987, ROCK, IRON AND MONUMENT BOX

SURVEY & REMONUMENTATION

MAR 18 2000

SECTION

B. Description of corner evidence found and/or method applied in restoring or reestablishing corner:


FOUND RAILROAD SPIKE IN MONUMENT BOX OVER LARGE SQUARE STONE 1' BY 1' BY 3.5' WITH DRILL HOLE IN TOP.
REPLACED STONE WITH BERNTSEN MONUMENT IN MONUMENT BOX 1' BELOW GRAVEL SURFACE.

C. Description of monument for corner and accessories established to perpetuate locating the position of the corner:

BERNTSEN MONUMENT IN CASTING 1' BELOW GRAVEL SURFACE
10" WALNUT N 04°W, 187.15' (NAIL AND SPOTTER)
14" WALNUT S 87°W, 165.94' (NAIL AND SPOTTER)
6" WALNUT S 01°W, 35.70' (NAIL AND SPOTTER)
20" WALNUT S 67°E, 38.44' (NAIL AND SPOTTER)
2' ± SOUTH OF CENTERLINE EAST-WEST ROAD
2' ± EAST OF CENTERLINE NORTH-SOUTH ROAD

THIS LOCATION IS ACCEPTED AS THE BEST AVAILABLE EVIDENCE OF THE POSITION OF THE ORIGINAL CORNER.

Signed by _____
Surveyor's Michigan License No. 20704

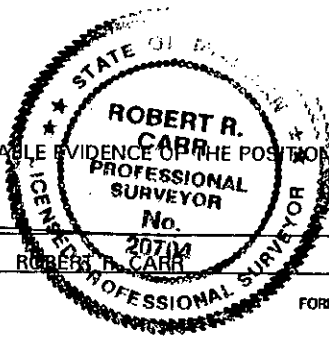

Date 8-18-99