

MAR 30 1999

APPROVED

Date 11-18-98 RRC
CALHOUN COUNTY
REMONUMENTATION.

CALHOUN COUNTY REMONUMENTATION
LAND CORNER RECORDATION CERTIFICATE
Filing Requirement of Act 74, Mich. P.A. 1970

SECTION

STATE OF MICHIGAN
CALHOUN COUNTY
RECORDED

19 NOV 1998 3:31:43 PM

ANNE D. NORLANDER
CLERK - REGISTER OF DEEDS

LIBER **2079** PAGE **917**

Register of Deeds Stamp & File Number

For corners in

<u>CALHOUN</u> (County)	Located In:	Corner Code #
ATHENS TOWNSHIP	T <u>4S</u> R <u>8W</u>	<u>E-5</u>
1. Public Land Survey	T _____ R _____	_____
	T _____ R _____	_____
	T _____ R _____	_____
2. Property Controlling in Section	S _____ T _____ R _____	_____
	S _____ T _____ R _____	_____
3. Miscellaneous Property in Sec.	S _____ T _____ R _____	_____
	S _____ T _____ R _____	_____

4. Lot No. _____, Recorded Plat _____
5. Private Claims _____

I, ROBERT R. CARR, in a field survey on NOVEMBER, 19 98 do hereby state that under requirements of P.A. 74, Michigan P.A. of 1970, the corner points mentioned in lines 1 and 2 above were in conformance with regulations and rules therefore as required in the current manual of survey instructions of the United States Department of the Interior, Bureau of Land Management or by a decree of a Court of Law and /or that the corner points mentioned in lines 3, 4 and 5 above were in conformance with the rules of the Michigan Board of Land Surveyors or by a Decree of a Court of Law; established, re-established, monumented, recovered, found as expressed below:

NOTE: Not more than 2 corners, all in the same town and range, may be recorded on this certificate.

CORNER COMMON TO SECTIONS 8, 9, 16 & 17
A. Description of original monument and accessories and/or subsequent restoration:

ORIGINAL CORNER SET BY ROBERT CLARK, D.S. 1826
F.A. COURTRIGHT, RESURVEY 1896, SET TILE

	A	B	C	D	E	F	G	H	I	J	K	L	M
1													
2		6		5		4		3		2		1	
3													
4		7		8		9		10		11		12	
5					16								
6		18		17		16		15		14		13	
7													
8		19		20		21		22		23		24	
9													
10		30		29		28		27		26		25	
11													
12		31		32		33		34		35		36	
13													

B. Description of corner evidence found and/or method applied in restoring or reestablishing corner:


FOUND TILE SET BY COURTRIGHT IN 1896.
REMOVED TOP TILE AND PLACED HARRISON MONUMENT OVER
BOTTOM TILE 0.8 FEET BELOW GRAVEL SURFACE.
LARGE SQUARE WHITE ROCK ON EAST SIDE.

C. Description of monument for corner and accessories established to perpetuate locating the position of the corner:

HARRISON MONUMENT OVER TILE WITH LARGE SQUARE WHITE STONE
ON EAST SIDE 0.8 FEET BELOW GRAVEL SURFACE.

- 28" APPLE, N10°E 165.65 FEET (SET SPOTTER)
- 5" MAPLE, N80°E 44.00 FEET (SET SPOTTER)
- 40" MAPLE, S85°W 17.40 FEET (SET SPOTTER)
- TWIN 8" & 10" CHERRY, N72°W 58.85 FEET (SET SPOTTER)
- IN TREE ROW TO WEST
- 4' ± WEST OF CENTERLINE OF N&S ROAD.

AND IS ACCEPTED AS A CAREFUL AND FAITHFUL PERPETUATION OF THE POSITION OF THE ORIGINAL CORNER.

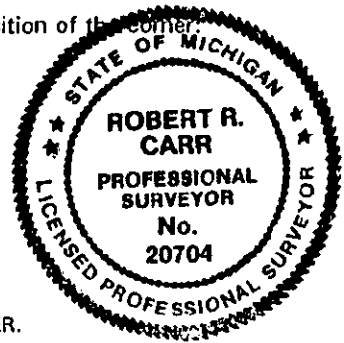

Signed by [Signature] Date NOVEMBER 16, 1998
Surveyor's Michigan License No. 20704 ROBERT R. CARR