

**SURVEY &
REMONUMENTATION**

APR 26 1995

APPROVED

Date 11-28-94
**CALHOUN COUNTY
REMONUMENTATION**

**COMMISSION
CALHOUN COUNTY REMONUMENTATION
LAND CORNER RECORDATION CERTIFICATE
Filing Requirement of Act 74, Mich. P.A. 1970**

STATE OF MICHIGAN
CALHOUN COUNTY
RECORDED

29 NOV 94 10:22 A.M.

ANNE B. NORLANDER
CLERK - REGISTER OF DEEDS

For corners in

CALHOUN (County)	Located In:	Corner Code #
ATHENS TWP.	T <u>4</u> S R <u>8</u> W	<u>E-9</u>
1. Public Land Survey	T _____ R _____	_____
	T _____ R _____	_____
	T _____ R _____	_____
2. Property Controlling in Section	S _____ T _____ R _____	_____
	S _____ T _____ R _____	_____
3. Miscellaneous Property in Sec.	S _____ T _____ R _____	_____
	S _____ T _____ R _____	_____

Register of Deeds Stamp & File Number

4. Lot No. _____, Recorded Plat _____
5. Private Claims _____

I, ROBERT R. CARR, in a field survey on NOVEMBER 10, 19 94, do hereby certify that under requirements of P.A. 74, Michigan P.A. of 1970, the corner points mentioned in lines 1 and 2 above were in conformance with regulations and rules therefore as required in the current manual of survey instructions of the United States Department of the Interior, Bureau of Land Management or by a decree of a Court of Law and/or that the corner points mentioned in lines 3, 4 and 5 above were in conformance with the rules of the Michigan Board of Land Surveyors or by a Decree of a Court of Law; established, re-established, monumented, re-monumented, recovered, found as expressed below:

NOTE: Not more than 4 corners, all in the same town and range, may be recorded on this certificate.

	A	B	C	D	E	F	G	H	I	J	K	L	I
2	6	5	4	3	2	1							
3													
4	7	8	9	10	11	12							
5													
6	18	17	16	15	14	13							
7													
8	19	20	21	22	23	24							
9													
10	30	29	28	27	26	25							
11													
12	31	32	33	34	35	36							
13													

A. Description of original monument and accessories and/or subsequent restoration:

ORIGINAL CORNER SET BY DEPUTY SURVEYOR ROBERT CLARK 1826.
RE-SURVEY BY COUNTY SURVEYOR F.A. COURTWRIGHT 1896.
FOUND IRON PIPE WHICH WAS SET FOR CORNER BY PHELPS, LEFT SAME FOR POST, NO TREES NEAR.
L.C.R.C. LIBER 1201, PAGE 691 BY GARY C. BILOW 1980.
FOUND 2"± IRON PIPE AND OLD WITNESS POST 12" BELOW MUD
RAISED WITH 1"X6' IRON PIPE WITH 4" ALUMINUM CAP.


B. Description of corner evidence found and/or method applied in restoring or reestablishing corner:

FOUND IRON PIPE WITH ALUMINUM CAP AS PER L.C.R.C. ABOVE IN GOOD CONDITION, SOME WITNESSES REMAINING.
PLACED CARSENITE WITNESS POST BESIDE.

C. Description of monument for corner and accessories established to perpetuate locating the position of the corner:

1" IRON PIPE WITH 4" ALUMINUM D.N.R. CAP WITH CARSENITE WITNESS POST BESIDE.
NAIL & SPOTTER IN NW SIDE OF CLUMP OF 3 -6" TO 10" MAPLES S25°W 9.15 FEET.
NAIL & SPOTTER IN NORTH SIDE OF CLUMP OF 4- 6" TO 10" MAPLES S85°W 20.80 FEET.
NAIL & SPOTTER IN NORTHEAST SIDE OF CLUMP OF 5- 6" TO 8" MAPLES N40°W 51.26 FEET.
NAIL & SPOTTER IN EAST SIDE OF 6" ASH N03°W 32.75 FEET.
NAIL & SPOTTER IN SOUTH SIDE OF 12" ASH N79°E 42.56 FEET.

LIBER 1778 PAGE 563

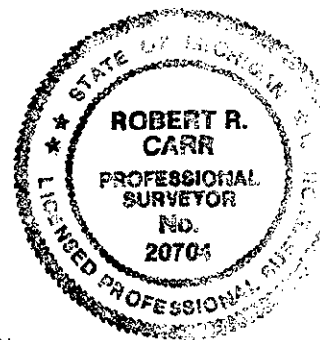

Signed by [Signature]
ROBERT R. CARR
Surveyor's Michigan License No. 20704

Date NOVEMBER 28, 1994