

**SURVEY &
REMONUMENTATION**

APR 26 1995

COMMISSION

STATE OF MICHIGAN
CALHOUN COUNTY
RECORDED

29 NOV 94 10:23 A.M.

ANNE B. NORLANDER
CLERK - REGISTER OF DEEDS

Register of Deeds Stamp & File Number

APPROVED

Date 11-28-94
**CALHOUN COUNTY
REMONUMENTATION.**

**CALHOUN COUNTY REMONUMENTATION
LAND CORNER RECORDATION CERTIFICATE
Filing Requirement of Act 74, Mich. P.A. 1970**

For corners in

<u>CALHOUN</u> (County)	Located In:	Corner Code #
ATHENS TWP.	T 4 S R 8 W	E-10
1. Public Land Survey	T _____ R _____	_____
	T _____ R _____	_____
	T _____ R _____	_____
2. Property Controlling in Section	S _____ T _____ R _____	_____
	S _____ T _____ R _____	_____
3. Miscellaneous Property in Sec.	S _____ T _____ R _____	_____
	S _____ T _____ R _____	_____
4. Lot No. _____, Recorded Plat _____		
5. Private Claims _____		

I, ROBERT R. CARR, in a field survey on NOVEMBER 9, 19 94, do hereby certify that under requirements of P.A. 74, Michigan P.A. of 1970, the corner points mentioned in lines 1 and 2 above were in conformance with regulations and rules therefore as required in the current manual of survey instructions of the United States Department of the Interior, Bureau of Land Management or by a decree of a Court of Law and/or that the corner points mentioned in lines 3, 4 and 5 above were in conformance with the rules of the Michigan Board of Land Surveyors or by a Decree of a Court of Law; established, re-established, monumented, re-monumented, recovered, found as expressed below:

NOTE: Not more than 4 corners, all in the same town and range, may be recorded on this certificate.

A. Description of original monument and accessories and/or subsequent restoration:

ORIGINAL CORNER SET BY DEPUTY SURVEYOR, ROBERT CLARK, 1826.
RE-SURVEY CORNER BY COUNTY SURVEYOR, F.A. COURTWRIGHT, 1896.
SET AT PROPORTIONAL DISTANCE 40.28 CHAINS FROM SE CORNER
24" Y OAK NORTH 145 LINKS 18" W OAK S1-1/2°E 2.48 LINKS.

B. Description of corner evidence found and/or method applied in restoring or reestablishing corner:


CORNER IS IN CULTIVATED FIELD.
TRAVERSED NORTH 2653 FEET PER RE-SURVEY NOTES AND LINED IN WITH REMAINS OF FENCE LINE NORTH AND DUG. FOUND 3" HOLLOW TILE DEEP WITH PIECES OF BROKEN TILE AND BRICK OVER.
PLACED BERNTSEN MONUMENT 1.5 FEET BELOW SURFACE WITH CARSENITE WITNESS POST ON NORTH SIDE.

	A	B	C	D	E	F	G	H	I	J	K	L	M
2	6	5	4	3	2	1							
3													
4	7	8	9	10	11	12							
5													
6	18	17	16	15	14	13							
7													
8	19	20	21	22	23	24							
9													
10	30	29	28	27	26	25							
11													
12	31	32	33	34	35	36							
13													

LIBER 1778 PAGE 566

C. Description of monument for corner and accessories established to perpetuate locating the position of the corner:

BERNTSEN MONUMENT 1.5 FEET BELOW SURFACE IN CULTIVATED FIELD.
NORTH EDGE OF CULTIVATED FIELD NORTH 93 FEET.
NAIL & SPOTTER IN SE SIDE OF 30" OAK N59°E 193.43 FEET.
NAIL & SPOTTER IN EASTERLY SIDE OF 30" OAK N17°E 152.50 FEET.
NAIL & SPOTTER IN EAST SIDE OF 28" OAK N03°W 169.20 FEET.
NAIL & SPOTTER IN NE SIDE OF 8" WALNUT N22°W 133.92 FEET.

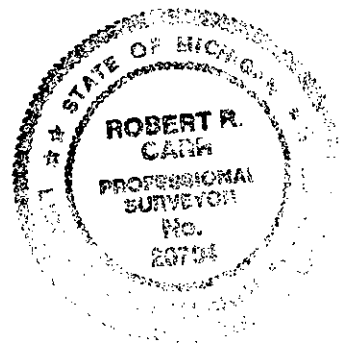

Signed by Robert R. Carr
ROBERT R. CARR
Surveyor's Michigan License No. 20704

Date NOVEMBER 28, 1994