

APPROVED

Date 8-13-94
**CALHOUN COUNTY
REMONUMENTATION.**

**CALHOUN COUNTY REMONUMENTATION
LAND CORNER RECORDATION CERTIFICATE
Filing Requirement of Act 74, Mich. P.A. 1970**

**SURVEY &
REMONUMENTATION**

OCT 24 1994

COMMISSION

For corners in

CALHOUN (County)	Located In:	Corner Code ##
ATHENS TWP.		
1. Public Land Survey	T <u>4</u> S R <u>8</u> W	<u>E-11</u>
	T _____ R _____	_____
	T _____ R _____	_____
	T _____ R _____	_____
2. Property Controlling in Section	S _____ T _____ R _____	_____
	S _____ T _____ R _____	_____
3. Miscellaneous Property in Sec.	S _____ T _____ R _____	_____
	S _____ T _____ R _____	_____
4. Lot No. _____, Recorded Plat _____		
5. Private Claims _____		

STATE OF MICHIGAN
CALHOUN COUNTY
RECORDED

18 AUG 94 12:13 P.M.

ANNE B. NORLANDER
CLERK - REGISTER OF DEEDS

Register of Deeds Stamp & File Number

I, ROBERT R. CARR, in a field survey on AUGUST 4, 19 94, do hereby certify that under requirements of P.A. 74, Michigan P.A. of 1970, the corner points mentioned in lines 1 and 2 above were in conformance with regulations and rules therefore as required in the current manual of survey instructions of the United States Department of the Interior, Bureau of Land Management or by a decree of a Court of Law and/or that the corner points mentioned in lines 3, 4 and 5 above were in conformance with the rules of the Michigan Board of Land Surveyors or by a Decree of a Court of Law; established, re-established, monumented, re-monumented, recovered, found as expressed below:

NOTE: Not more than 4 corners, all in the same town and range, may be recorded on this certificate.

	A	B	C	D	E	F	G	H	I	J	K	L	M
2	6	5	4	3	2	1							
3													
4	7	8	9	10	11	12							
5													
6	18	17	16	15	14	13							
7													
8	19	20	21	22	23	24							
9													
10	30	29	28	27	26	25							
11													
12	31	32	33	34	35	36							
13													

A. Description of original monument and accessories and/or subsequent restoration:

ORIGINAL CORNER SET BY DEPUTY SURVEYOR, ROBERT CLARK, 1826.
RE-SURVEY BY COUNTY SURVEYOR, F.A. COURTWRIGHT, 1896.
FOUND REMAINS OF STAKE AND SET POST
5" SPRUCE N71°W 200 LKS; 5" EVERGREEN N64°W 222 LKS.
R. R. CARR, P.S. NO. 20704, 1986, 1" IRON, SW CORNER SMALL BARN N73°50'W, 34.80 FT.
SE CORNER SMALL BARN N04°20'E, 32.50 FT. IN LINE WITH FENCES EAST & SOUTH.


B. Description of corner evidence found and/or method applied in restoring or reestablishing corner:

FOUND 1/2" IRON MATCHING WITNESS BY CARR TO SMALL BARN
ALSO FOUND 30" PINE N71°W, 131.5 FT TO CENTER (RE-SURVEY WITNESS).
DUG & FOUND BROKEN TILE, BRICKS & STONES UNDER 1/2" IRON.
SET BERNTSEN MONUMENT WITH BROKEN TILE, BRICK & CONCRETE AROUND.

LIBER 1763 PAGE 771

C. Description of monument for corner and accessories established to perpetuate locating the position of the corner:

BERNTSEN MONUMENT
NAIL & SPOTTER IN SOUTH SIDE OF 30" PINE N71°W, 131.51 FT.
NAIL & SPOTTER IN WESTERLY SIDE OF 12" CHERRY S34°W, 64.21 FT.
SW CORNER CONCRETE BLOCK BARN N21°W, 34.66 FT.
SE CORNER CONCRETE BLOCK BARN N18°W 32.43 FT.
IN LINE WITH FENCES TO EAST & SOUTH & CENTERLINE ROAD TO WEST.

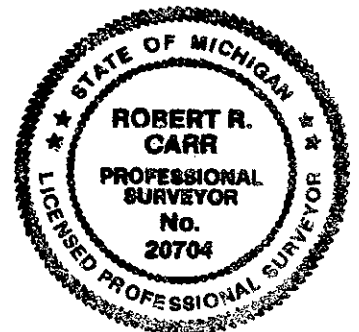

Signed by Robert R. Carr Date AUGUST 15, 1994
Surveyor's Michigan License No. 20704