

**APPROVED**  
 Date 8-17-94  
**CALHOUN COUNTY**  
**REMONUMENTATION.**

**SURVEY & REMONUMENTATION**

OCT 24 1994

COMMISSIONER

**CALHOUN COUNTY REMONUMENTATION**  
**LAND CORNER RECORDATION CERTIFICATE**  
 Filing Requirement of Act 74, Mich. P.A. 1970

STATE OF MICHIGAN  
 CALHOUN COUNTY  
 RECORDED

18 AUG 94 12:13 P.M.

ANNE B. NORLANDER  
 CLERK - REGISTER OF DEEDS

Register of Deeds Stamp & File Number

For corners in

CALHOUN (County)	Located In:	Corner Code ##
ATHENS TWP		
1. Public Land Survey	T 4 S R 8 W	E-12
	T R	
	T R	
	T R	
2. Property Controlling in Section	S T R	
	S T R	
3. Miscellaneous Property in Sec.	S T R	
	S T R	
4. Lot No. _____, Recorded Plat _____		
5. Private Claims _____		

	A	B	C	D	E	F	G	H	I	J	K	L	M
2	6	5	4	3	2	1							
3													
4	7	8	9	10	11	12							
5													
6	18	17	16	15	14	13							
7													
8	19	20	21	22	23	24							
9													
10	30	29	28	27	26	25							
11													
12	31	32	33	34	35	36							
13													

I, ROBERT R. CARR, in a field survey on AUGUST 4, 19 94, do hereby certify that under requirements of P.A. 74, Michigan P.A. of 1970, the corner points mentioned in lines 1 and 2 above were in conformance with regulations and rules therefore as required in the current manual of survey instructions of the United States Department of the Interior, Bureau of Land Management or by a decree of a Court of Law and/or that the corner points mentioned in lines 3, 4 and 5 above were in conformance with the rules of the Michigan Board of Land Surveyors or by a Decree of a Court of Law; established, re-established, monumented, re-monumented, recovered, found as expressed below:

**NOTE: Not more than 4 corners, all in the same town and range, may be recorded on this certificate.**

**A. Description of original monument and accessories and/or subsequent restoration:**

ORIGINAL CORNER SET BY DEPUTY SURVEYOR, ROBERT CLARK, 1826.  
 RE-SURVEY BY COUNTY SURVEYOR, F.A. COURTWRIGHT, 1896.  
 FOUND ONE BEARING STUMP & SET POST  
 SWAMP OAK 9" N1°E 70.5 LKS  
 L.C.R.C. FILE NO. 1-171  
 L.C.R.C. FILE NO. 2-387


**B. Description of corner evidence found and/or method applied in restoring or reestablishing corner:**

FOUND 5/8" IRON MATCHING WITNESSES FROM L.C.R.C. FILE NO. 1-171 & FILE NO. 2-387.  
 DUG 6'X4' HOLE 4' DEEP, FOUND OLD WIRE FENCE 2'± BELOW 5/8" IRON.  
 NO EVIDENCE OF TILE FOUND ROAD HAS BEEN CUT 3' TO 5' FROM ORIGINAL GROUND.  
 SET HARRISON MONUMENT WITH STONES AROUND AT LOCATION OF 5/8" IRON.

LIBER 1763 PAGE 770

**C. Description of monument for corner and accessories established to perpetuate locating the position of the corner:**

HARRISON MONUMENT WITH STONES 1.0' BELOW GRAVEL SURFACE.  
 NAIL & SPOTTER IN EASTERLY SIDE OF TWIN 48" OAK N24°W.28.79 FT.  
 NAIL & SPOTTER IN NORTHERLY SIDE OF 32" OAK S66°W 42.14 FT.  
 NAIL & SPOTTER IN SOUTHEASTERLY SIDE OF 30" OAK N58°E 53.02 FT.  
 NAIL & SPOTTER IN WESTERLY SIDE OF 36" OAK S13°W 12.15 FT.  
 8' ± SOUTH OF CENTERLINE ROAD, IN LINE WITH FENCE TO SOUTH.

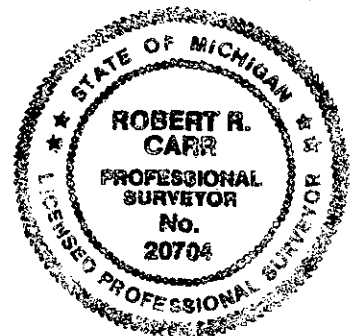

Signed by [Signature]  
 ROBERT R. CARR  
 Surveyor's Michigan License No. 20704

Date AUGUST 15, 1994