

APPROVED

Date 11-28-94

CALHOUN COUNTY REMONUMENTATION

CALHOUN COUNTY REMONUMENTATION LAND CORNER RECORDATION CERTIFICATE Filing Requirement of Act 74, Mich. P.A. 1970

For corners in

CALHOUN

(County)

ATHENS TWP

Located In:

Corner Code #

1. Public Land Survey

T 4 S R 8 W

F-13

2. Property Controlling in Section

S T R

3. Miscellaneous Property in Sec.

S T R

4. Lot No. , Recorded Plat

5. Private Claims

STATE OF MICHIGAN CALHOUN COUNTY RECORDED

29 DEC 94 10:54 A.M.

ANNE B. NORLANDER CLERK - REGISTER OF DEEDS

Register of Deeds Stamp & File Number

I, ROBERT R. CARR, in a field survey on OCTOBER 19, 1994, do hereby certify that under requirements of P.A. 74, Michigan P.A. of 1970, the corner points mentioned in lines 1 and 2 above were in conformance with regulations and rules therefore as required in the current manual of survey instructions of the United States Department of the Interior, Bureau of Land Management or by a decree of a Court of Law and/or that the corner points mentioned in lines 3, 4 and 5 above were in conformance with the rules of the Michigan Board of Land Surveyors or by a Decree of a Court of Law; established, re-established, monumented, re-monumented, recovered, found as expressed below:

NOTE: Not more than 4 corners, all in the same town and range, may be recorded on this certificate.

A. Description of original monument and accessories and/or subsequent restoration:

GLO - ROBERT CLARK 1826. RE-SURVEY F.A. COURTWRIGHT 1896. ALL EVIDENCE OF POST & BEARINGS GONE; SET POST 23 LINKS EAST FROM 1/4 LINE FENCE RUNNING SOUTH IN SHERWOOD TOWNSHIP, BRANCH COUNTY.

B. Description of corner evidence found and/or method applied in restoring or reestablishing corner:

FOUND 3 HOLLOW TILES FILLED WITH BITS OF BRICK AND BROKEN GLASS. NO EVIDENCE OF BRANCH COUNTY CORNER OR FENCE TO SOUTH REMAINING. STACK OF 3 HOLLOW TILES IS SAME AS FOUND ON MANY OTHER ATHENS TOWNSHIP CORNERS IN SECTIONS 27, 28, 33 AND 34. ACCEPTED TILES AS CORNER SET BY COURTWRIGHT IN 1896 AND REPLACED TILES WITH BRENTSEN MONUMENT WITH 3 LARGE STONES, BRICK AND GLASS AROUND.

REMONUMENTATION


FEB 22 1996

COMMISSION

LIBER 1782 PAGE 960

C. Description of monument for corner and accessories established to perpetuate locating the position of the corner:

BRENTSEN MONUMENT WITH CARBONITE WITNESS POST BESIDE. MONUMENT IS 1.0 FT± SOUTH OF EAST/WEST FENCE LINE AND 350 FT± WEST OF FENCE LINE RUNNING NORTH. NAIL & SPOTTER IN WEST SIDE OF U-POLE S11°E 2.0 FT. NAIL & SPOTTER IN NORTH SIDE OF 8" WILD CHERRY N78°W 15.63 FT. NAIL & SPOTTER IN SOUTHERLY SIDE OF 6" ELM S85°E 45.65 FT. NAIL & SPOTTER IN SOUTHWESTERLY SIDE OF 10" WOOD FENCE POST S75°E 10.70 FT.

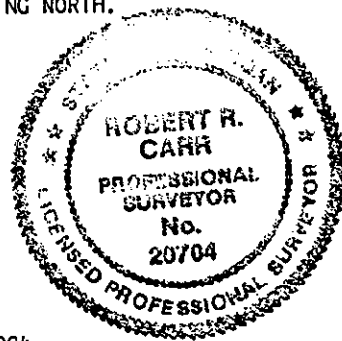

Signed by ROBERT R. CARR Surveyor's Michigan License No. 20704

Date DECEMBER 20, 1994

Grid table with columns A-M and rows 2-13, containing numbers 1-36 and a dot at row 13, column F.