

APPROVED

Date 12-16-97 *RRC*
**CALHOUN COUNTY
REMONUMENTATION.**

**CALHOUN COUNTY REMONUMENTATION
LAND CORNER RECORDATION CERTIFICATE**
Filing Requirement of Act 74, Mich. P.A. 1970

STATE OF MICHIGAN
CALHOUN COUNTY
RECORDED

19 DEC 97 2:40 P.M.

ANNE B. NORLANDER
CLERK - REGISTER OF DEEDS

LIBER **1985** PAGE **534**

Register of Deeds Stamp & File Number

For corners in

<u>CALHOUN</u>	Located In:	Corner Code #
(County)		
ATHENS TOWNSHIP		
1. Public Land Survey	T <u>4S</u> R <u>8W</u>	<u>G-7</u>
	T _____ R _____	_____
	T _____ R _____	_____
	T _____ R _____	_____
2. Property Controlling	S _____ T _____ R _____	_____
in Section	S _____ T _____ R _____	_____
3. Miscellaneous	S _____ T _____ R _____	_____
Property in Sec.	S _____ T _____ R _____	_____

4. Lot No. _____, Recorded Plat _____
5. Private Claims _____

I, ROBERT R. CARR, in a field survey on DECEMBER 8, 1997 do hereby state that under requirements of P.A. 74, Michigan P.A. of 1970, the corner points mentioned in lines 1 and 2 above were in conformance with regulations and rules therefore as required in the current manual of survey instructions of the United States Department of the Interior, Bureau of Land Management or by a decree of a Court of Law and /or that the corner points mentioned in lines 3, 4 and 5 above were in conformance with the rules of the Michigan Board of Land Surveyors or by a Decree of a Court of Law; established, re-established, monumented, recovered, found as expressed below:

NOTE: Not more than 2 corners, all in the same town and range, may be recorded on this certificate.

A. Description of original monument and accessories and/or subsequent restoration:

1826 ROBERT CLARK D.S. W.O. 12" S52°W 83 LKS, W.O. 11" N2°E 12-1/2 LKS.
1896 COURTRIGHT RESURVEY, TILE UNDER STONE
W. OAK 16" S80°W 7-1/2 LKS, W. OAK DOUBLE S1°E 31-1/2 LKS

	A	B	C	D	E	F	G	H	I	J	K	L	M
1													
2	6		5		4		3		2		1		
3													
4	7		8		9		10		11		12		
5													
6	18		17		16		15		14		13		
7							1						
8	19		20		21		22		23		24		
9													
10	30		29		28		27		26		25		
11													
12	31		32		33		34		35		36		
13													

**SURVEY &
REMONUMENTATION**

APR 07 1998

SECTION


B. Description of corner evidence found and/or method applied in restoring or reestablishing corner:

GLO AND RESURVEY WITNESSES GONE
FOUND 1/2" IRON OVER 3" HOLLOW TILE IN E-W FENCE

ACCEPTED TILE AS TRUE PERPETUATION OF CORNER AND REPLACED TILE WITH
BERNTSEN MONUMENT WITH CARSONITE WITNESS POST BESIDE.

C. Description of monument for corner and accessories established to perpetuate locating the position of the corner:

BERNTSEN MONUMENT WITH CARSONITE WITNESS POST BESIDE
SET SPOTTER IN 8" SASSAFRAS, N90°W 13.66 FEET
SET SPOTTER IN 5" SASSAFRAS, S55°W 7.55 FEET
SET SPOTTER IN 18" W. OAK, S25°W 21.39 FEET
SET SPOTTER IN 10" OAK, S85°E 42.58 FEET.

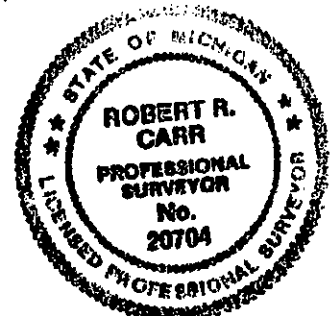

Signed by [Signature]
Surveyor's Michigan License No. 20704

Date 12-15-97