

**SURVEY &
REMONUMENTATION**

APR 26 1995

**COMMISSION
CALHOUN COUNTY REMONUMENTATION
LAND CORNER RECORDATION CERTIFICATE
Filing Requirement of Act 74, Mich. P.A. 1970**

APPROVED
Date 10-17-94
**CALHOUN COUNTY
REMONUMENTATION.**

For corners in

<u>CALHOUN</u> (County)	Located In:	Corner Code #
<u>ATHENS TWP</u>		
1. Public Land Survey	T <u>4 S</u> R <u>8 W</u>	<u>G-9</u>
	T _____ R _____	_____
	T _____ R _____	_____
	T _____ R _____	_____
2. Property Controlling in Section	S _____ T _____ R _____	_____
	S _____ T _____ R _____	_____
3. Miscellaneous Property in Sec.	S _____ T _____ R _____	_____
	S _____ T _____ R _____	_____

STATE OF MICHIGAN
CALHOUN COUNTY
RECORDED

Register of Deeds Stamp File Number

4. Lot No. _____, Recorded Plat _____
5. Private Claims _____

I, ROBERT R. CARR, in a field survey on OCTOBER 10, 19 94, do hereby certify that under requirements of P.A. 74, Michigan P.A. of 1970, the corner points mentioned in lines 1 and 2 above were in conformance with regulations and rules therefore as required in the current manual of survey instructions of the United States Department of the Interior, Bureau of Land Management or by a decree of a Court of Law and/or that the corner points mentioned in lines 3, 4 and 5 above were in conformance with the rules of the Michigan Board of Land Surveyors or by a Decree of a Court of Law; established, re-established, monumented, re-monumented, recovered, found as expressed below:

NOTE: Not more than 4 corners, all in the same town and range, may be recorded on this certificate.

ANNE B. NORLANDER
CLERK OF REGISTER OF DEEDS

A	6	5	4	3	2	1
2						
3						
4	7	8	9	10	11	12
5						
6	18	17	16	15	14	13
7						
8	19	20	21	22	23	24
9						
10	30	29	28	27	26	25
11						
12	31	32	33	34	35	36
13						

A. Description of original monument and accessories and/or subsequent restoration:

ORIGINAL CORNER SET BY DEPUTY SURVEYOR ROBERT CLARK 1826.
RE-SURVEY BY COUNTY SURVEYOR F.A. COURTWRIGHT 1896.
SET POST (TILE) AT AVERAGE DISTANCE BETWEEN SE CORNER SECTION 16 & SE CORNER SECTION 28. (79.94 CH).
16" BLACK WALNUT N83°W 53 LKS.
12" MAPLE N32°W 82 LKS.


B. Description of corner evidence found and/or method applied in restoring or reestablishing corner:

FOUND 3/4" PIPE OVER BOLT OVER HOLLOW TILE WITH BRICK AROUND IN MONUMENT BOX.
SET BERNTSEN MONUMENT IN MONUMENT BOX WITH PIECES OF TILE & BRICK AROUND.
ACCEPTED HOLLOW TILE AS RE-SURVEY CORNER BY COURTWRIGHT.

LIBER 1773 PAGE 887

C. Description of monument for corner and accessories established to perpetuate locating the position of the corner:

BERNTSEN MONUMENT IN MONUMENT BOX.
NAIL & SPOTTER IN WEST SIDE 30" WALNUT S78°W 123.31 FT.
NAIL & SPOTTER IN NWLY SIDE 28" WALNUT S35°W 55.09 FT.
NAIL & SPOTTER IN E SIDE 14" WALNUT N11°W 91.62 FT.
SE CORNER HOUSE FOUNDATION #2059 N77°W 162.92 FT.

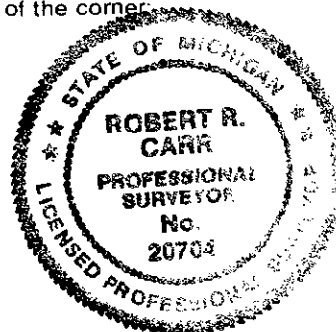

Signed by *Robert R. Carr* Date OCTOBER 17, 1994
Surveyor's Michigan License No. 20704