

SURVEY & REMONUMENTATION

APR 26 1995

COMMISSION CALHOUN COUNTY REMONUMENTATION LAND CORNER RECORDATION CERTIFICATE Filing Requirement of Act 74, Mich. P.A. 1970

APPROVED
te 10-59-57
**CALHOUN COUNTY
REMONUMENTATION.**

For corners in
CALHOUN

	Located In:	Corner Code #	
(County)			
ATHENS TWP			
1. Public Land Survey	T <u>4</u> S R <u>8</u> W	<u>G-10</u>	
	T _____ R _____	_____	
	T _____ R _____	_____	
	T _____ R _____	_____	
2. Property Controlling in Section	S _____ T _____ R _____	_____	
	S _____ T _____ R _____	_____	
3. Miscellaneous Property in Sec.	S _____ T _____ R _____	_____	
	S _____ T _____ R _____	_____	
4. Lot No. _____, Recorded Plat _____			
5. Private Claims _____			

STATE OF MICHIGAN
CALHOUN COUNTY
RECORDED

25 OCT 94 9:03 A.M.

ANNE B. NORLANDER
CLERK - REGISTER OF DEEDS

Register of Deeds Stamp & File Number

	A	B	C	D	E	F	G	H	I	J	K	L	M
2	6	5	4	3	2	1							
3													
4	7	8	9	10	11	12							
5													
6	18	17	16	15	14	13							
7													
8	19	20	21	22	23	24							
9													
10	30	29	28	27	26	25							
11													
12	31	32	33	34	35	36							
13													

I, ROBERT R. CARR, in a field survey on OCTOBER 10, 19 94, do hereby certify that under requirements of P.A. 74, Michigan P.A. of 1970, the corner points mentioned in lines 1 and 2 above were in conformance with regulations and rules therefore as required in the current manual of survey instructions of the United States Department of the Interior, Bureau of Land Management or by a decree of a Court of Law and/or that the corner points mentioned in lines 3, 4 and 5 above were in conformance with the rules of the Michigan Board of Land Surveyors or by a Decree of a Court of Law; established, re-established, monumented, re-monumented, recovered, found as expressed below:

NOTE: Not more than 4 corners, all in the same town and range, may be recorded on this certificate.

A. Description of original monument and accessories and/or subsequent restoration:

ORIGINAL CORNER SET BY DEPUTY SURVEYOR ROBERT CLARK 1826.
 RE-SURVEY BY COUNTY SURVEYOR F.A. COURTWRIGHT 1896.
 SET POST AT AVERAGE DISTANCE (39.97 ~~FT~~ ^{LKS}) BETWEEN NE & SE, 18" BLACK WALNUT S24°E 91-1/2 LKS
 26" MAPLE S25°W 121-1/4 LKS.
 GERTZ/DEKEYSER 1980 MONUMENT BOX 1 FT WEST OF CENTERLINE OF M-66
 2FT NORTH OF CENTERLINE NORTH STREET
 SE CORNER HOUSE N85°W 84.0 FT.
 28" WALNUT S60°W 50.5 FT.
 NW CORNER LAUNDRY S45°E 122.2 FT.
 NE FACE OF PP S30°± FT 42.0 FT.


B. Description of corner evidence found and/or method applied in restoring or reestablishing corner:

FOUND 3/4" IRON BAR IN SIDE HOLLOW TILE 1 FT DEEP IN MONUMENT BOX MATCHING GERTZ/DEKEYSER 1980 WITNESSES.
 RE-PLACED IRON BAR WITH BERNTSEN MONUMENT LEAVING TILE IN PLACE.
 ACCEPTED HOLLOW TILE AS RE-SURVEY CORNER BY COURTWRIGHT.

LIBER 1773 PAGE 888

C. Description of monument for corner and accessories established to perpetuate locating the position of the corner:

BERNTSEN MONUMENT IN HOLLOW TILE IN MONUMENT BOX.
 SE CORNER RESTURANT BLDG N66°E 188.54 FT.
 NW CORNER LAUNDRY BLDG S38°E 122.12 FT.
 NE CORNER HOUSE FOUNDATION S48°W 133.37 FT.
 SE CORNER HOUSE FOUNDATION N72°W 84.00 FT.

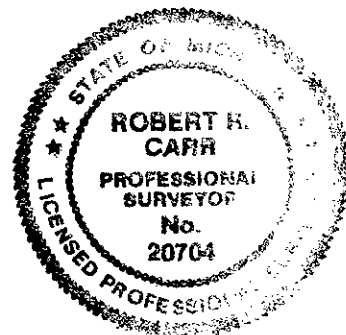

Signed by Robert R. Carr Date OCTOBER 18, 1994
 Surveyor's Michigan License No. 20704