APPROVED
Date 10-19-94
CALHOUN COUNTY
REMONUMENTATION

SURVEY &
REMONUMENTATION
APR 26 1995
COMMISSION

CALHOUN COUNTY REMONUMENTATION
LAND CORNER RECORDATION CERTIFICATE
Filing Requirement of Act 74, Mich. P.A. 1970

For corners in
CALHOUN
(County)

	Located In:	Corner Code ##
ATHENS TWP		
1. Public Land Survey	T 4 S R 8 W	G-11
	T ___ R ___	
	T ___ R ___	
	T ___ R ___	
2. Property Controlling	S ___ T ___ R ___	
in Section	S ___ T ___ R ___	
3. Miscellaneous	S ___ T ___ R ___	
Property in Sec.	S ___ T ___ R ___	

STATE OF MICHIGAN
CALHOUN COUNTY
RECORDED

25 OCT 94 9:02 A.M.

ANNE B. NORLANDER
CLERK - REGISTER OF DEEDS

Register of Deeds Stamp & File Number

4. Lot No. _____, Recorded Plat _____
5. Private Claims _____

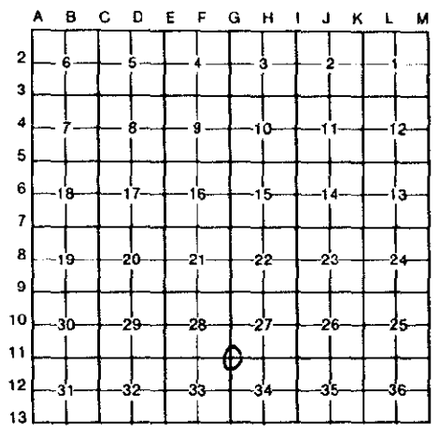

I, ROBERT R. CARR, in a field survey on OCTOBER 10, 19 94, do hereby certify that under requirements of P.A. 74, Michigan P.A. of 1970, the corner points mentioned in lines 1 and 2 above were in conformance with regulations and rules therefore as required in the current manual of survey instructions of the United States Department of the Interior, Bureau of Land Management or by a decree of a Court of Law and/or that the corner points mentioned in lines 3, 4 and 5 above were in conformance with the rules of the Michigan Board of Land Surveyors or by a Decree of a Court of Law; established, re-established, monumented, re-monumented, recovered, found as expressed below:

NOTE: Not more than 4 corners, all in the same town and range, may be recorded on this certificate.

A. Description of original monument and accessories and/or subsequent restoration:

ORIGINAL CORNER SET BY DEPUTY SURVEYOR ROBERT CLARK 1826.
RE-SURVEY BY COUNTY SURVEYOR F.A. COURTWRIGHT 1896.
FOUND BEARING TREE AND IRON BAR DID NOT SET TILE
L.C.R.C. LIBER 1032 PG 614.

B. Description of corner evidence found and/or method applied in restoring or reestablishing corner:

FOUND 1"X1-1/2" SQUARE IRON BAR IN CONCRETE IN MONUMENT BOX ALL WITNESSES FROM L.C.R.C. REMAINING.
ACCEPTED IRON BAR AS PERPETUATION OF ORIGINAL CORNER.
LEFT IRON BAR IN PLACE DID NOT SET RENONUMENTATION MONUMENT.

LIBER 1773 PAGE 885

C. Description of monument for corner and accessories established to perpetuate locating the position of the corner:

1"X1-1/2" IRON BAR IN CONCRETE IN MONUMENT BOX.
SW CORNER FOUNDATION HOUSE #223 N47°E 94.04 FT.
SE CORNER MARATHON STATION N75°W 62.30 FT.
SW CORNER BLDG N89°E 66.94 FT.
NE CORNER FUNERAL HOME FOUND S28°W 169.32 FT.
NW CORNER HOUSE FOUND S40-1/2°E 116.34 FT IN CENTERLINE M-66.

STATE OF MICHIGAN
ROBERT R. CARR
PROFESSIONAL SURVEYOR
No. 20704
LICENSED PROFESSIONAL SURVEYOR

Signed by _____ Date OCTOBER 17, 1994
ROBERT R. CARR
Surveyor's Michigan License No. 20704

FORM APPROVED BY MICHIGAN STATE BOARD OF LAND SURVEYORS, JAN. 28, 1971
REVISED MAY 14, 1975