

APPROVED

Date 12-16-97 RRC
CALHOUN COUNTY
REMONUMENTATION.

CALHOUN COUNTY REMONUMENTATION
LAND CORNER RECORDATION CERTIFICATE
 Filing Requirement of Act 74, Mich. P.A. 1970

STATE OF MICHIGAN
 CALHOUN COUNTY
 RECORDED

For corners in

<u>CALHOUN</u>	Located In:	Corner Code #
(County)		
ATHENS TOWNSHIP		
1. Public Land Survey	T <u>4S</u> R <u>8W</u>	<u>H-7</u>
	T _____ R _____	_____
	T _____ R _____	_____
	T _____ R _____	_____
2. Property Controlling in Section	S _____ T _____ R _____	_____
	S _____ T _____ R _____	_____
3. Miscellaneous Property in Sec.	S _____ T _____ R _____	_____
	S _____ T _____ R _____	_____
4. Lot No. _____, Recorded Plat _____		
5. Private Claims _____		

19 DEC 97 2:40 P.M.

ANNE B. NORLANDER
 CLERK - REGISTER OF DEEDS

LIBER 1985 PAGE 532

Register of Deeds Stamp & File Number

I, ROBERT R. CARR, in a field survey on DECEMBER 8, 19 97 do hereby state that under requirements of P.A. 74, Michigan P.A. of 1970, the corner points mentioned in lines 1 and 2 above were in conformance with regulations and rules therefore as required in the current manual of survey instructions of the United States Department of the Interior, Bureau of Land Management or by a decree of a Court of Law and/or that the corner points mentioned in lines 3, 4 and 5 above were in conformance with the rules of the Michigan Board of Land Surveyors or by a Decree of a Court of Law; established, re-established, monumented, recovered, found as expressed below:

NOTE: Not more than 2 corners, all in the same town and range, may be recorded on this certificate.

A	B	C	D	E	F	G	H	I	J	K	L	H
1												
2	6		5		4		3		2		1	
3												
4	7		8		9		10		11		12	
5												
6	18		17		16		15		14		13	
7							⊙					
8	19		20		21		22		23		24	
9												
10	30		29		28		27		26		25	
11												
12	31		32		33		34		35		36	
13												

A. Description of original monument and accessories and/or subsequent restoration:

1826 ROBERT CLARK D.S. W. OAK 12" S62°W 25-1/2 LKS, Y. OAK 16" S35°E 25 LKS.
 1896 COURTRIGHT, RESURVEY; MEASURED FROM SOUTHEAST TO SOUTHWEST CORNERS
 80.22 CHAINS AND SET POST IN CENTER OF EAST-WEST FENCE AT AVERAGE DISTANCE
 40.11 CH, MAPLE 8" S86°W 54 LKS
 1985 D.J. DAVIS, SET 5/8" IRON AT 1/2 DISTANCE, TRIPLE MAPLE S25°W 35 FEET, P. POLE S85°E 49.5 FEET
 CENTERLINE OF M-66 N65°W 62.2 FEET, 10 FEET SOUTH OF TREE ROW EAST.

SURVEY &
 REMONUMENTATION

APR 07 1998


SECTION

B. Description of corner evidence found and/or method applied in restoring or reestablishing corner:

PREVIOUS RESTORATION GONE
 RAN TRAVERSE FROM SOUTHWEST CORNER OF SECTION 15 TO SOUTHEAST CORNER
 DISTANCE FROM SOUTHWEST TO SOUTHEAST, COMPUTED 5295.91 FEET
 COURTRIGHT, 1896 MEASURED 80.22 CH (5294.52 FEET)
 RESET SOUTH 1/4 CORNER AT MIDPOINT AND ON LINE, LOCATION FITS EAST-WEST FENCE/TREE ROW.
 ACCEPTED THIS LOCATION AS BEST EVIDENCE OF ORIGINAL CORNER AND
 PLACED BERNTSEN MONUMENT AND CARSONITE WITNESS POST.

C. Description of monument for corner and accessories established to perpetuate locating the position of the corner:

BERNTSEN MONUMENT AND CARSONITE WITNESS POST
 SET SPOTTER IN UTILITY POLE, S79°E 43.80 FEET
 SET SPOTTER IN FENCE POST, N80°E 42.08 FEET
 SET SPOTTER IN 3" RED MAPLE, S4°E 33.16 FEET
 CENTERLINE OF M-66, N76°W 66.0 FEET, MORE OR LESS.

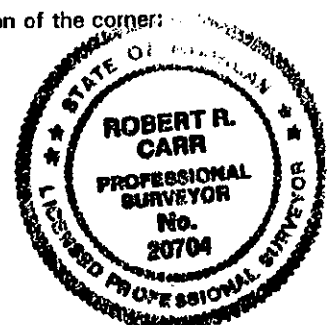

Signed by [Signature]
 Surveyor's Michigan License No. 20704

Date 12-15-97