

APR 26 1995

**APPROVED**

Date 11-28-94 LDG  
**CALHOUN COUNTY  
REMONUMENTATION.**

**CALHOUN COUNTY REMONUMENTATION  
LAND CORNER RECORDATION CERTIFICATE  
Filing Requirement of Act 74, Mich. P.A. 1970**

**COMMISSION  
STATE OF MICHIGAN  
CALHOUN COUNTY  
RECORDED**

For corners in

<u>CALHOUN</u> (County)	Located In:	Corner Code #
ATHENS TWP.		
1. Public Land Survey	T <u>4</u> S R <u>8</u> W	<u>H-9</u>
	T _____ R _____	_____
	T _____ R _____	_____
	T _____ R _____	_____
2. Property Controlling in Section	S _____ T _____ R _____	_____
	S _____ T _____ R _____	_____
3. Miscellaneous Property in Sec.	S _____ T _____ R _____	_____
	S _____ T _____ R _____	_____
4. Lot No. _____, Recorded Plat _____		
5. Private Claims _____		

29 NOV 94 10:22 A.M.

ANNE B. NORLANDER  
CLERK - REGISTER OF DEEDS

Register of Deeds Stamp & File Number

I, ROBERT R. CARR, in a field survey on NOVEMBER 23, 19 94, do hereby certify that under requirements of P.A. 74, Michigan P.A. of 1970, the corner points mentioned in lines 1 and 2 above were in conformance with regulations and rules therefore as required in the current manual of survey instructions of the United States Department of the Interior, Bureau of Land Management or by a decree of a Court of Law and/or that the corner points mentioned in lines 3, 4 and 5 above were in conformance with the rules of the Michigan Board of Land Surveyors or by a Decree of a Court of Law; established, re-established, monumented, re-monumented, recovered, found as expressed below:

	A	B	C	D	E	F	G	H	I	J	K	L
2	6	5	4	3	2	1						
3												
4	7	8	9	10	11	12						
5												
6	18	17	16	15	14	13						
7												
8	19	20	21	22	23	24						
9												
10	30	29	28	27	26	25						
11												
12	31	32	33	34	35	36						
13												

**NOTE: Not more than 4 corners, all in the same town and range, may be recorded on this certificate.**

**A. Description of original monument and accessories and/or subsequent restoration:**

ORIGINAL CORNER SET BY DEPUTY SURVEYOR ROBERT CLARK 1826.  
RE-SURVEY BY COUNTY SURVEYOR F.A. COURTWRIGHT 1896.  
MEASURED EAST FROM SOUTHEAST CORNER SECTION 21 40.20 CHAINS FOUND REMAINS OF ONE BEARING AND AN OLD STAKE AT INTERSECTION OF FENCES IN SWAMP.  
SET POST AND WITNESSES 18" ELM S60°W 54 LINKS 20" W OAK S85°W 109-1/2 LINKS.


**B. Description of corner evidence found and/or method applied in restoring or reestablishing corner:**

FOUND REMAINS OF DOWNED FENCE RUNNING EAST & WEST TREE ROW TO NORTH IN SWAMPY WOODS PROBED FOR TILE BUT COULD NOT FIND.  
TRAVERSED FROM NORTHWEST CORNER SECTION 27 TO NORTHEAST CORNER SECTION 27 AND ESTABLISHED MIDPOINT AT SPLIT OF 5304.03 (2652.01) FEET WHICH FITS FENCE/TREE ROW INTERSECTION RENEWED SEARCH FOR TILE BUT STILL COULD NOT FIND.  
SET BERNTSEN MONUMENT AT MIDPOINT WITH CARSENITE WITNESS MARKER BESIDE.

LIBER 1778 PAGE 565

**C. Description of monument for corner and accessories established to perpetuate locating the position of the corner:**

BERNTSEN MONUMENT OVER 1-1/2X48" IRON PIPE.  
NAIL & SPOTTER IN SLUTHERLY SIDE OF 24" MAPLE (TRIPLE) N20°E 11.40 FEET.  
NAIL & SPOTTER IN EASTERLY SIDE OF 20" OAK N13°W 47.83 FEET.  
NAIL & SPOTTER IN NORTHERLY SIDE OF 20" MAPLE N72°2 19.31 FEET.  
NAIL & SPOTTER IN NORTHERLY SIDE OF 12" OAK N78°W 83.34 FEET.  
NAIL & SPOTTER IN NORTHWESTERLY SIDE OF 18" MAPLE S29°W 26.84 FEET.

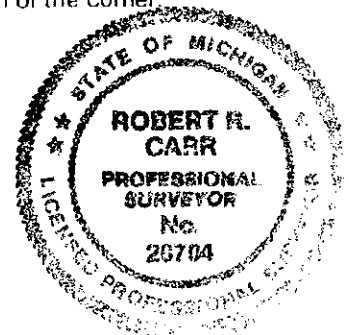

Signed by [Signature]  
ROBERT R. CARR  
Surveyor's Michigan License No. 20704

Date NOVEMBER 28, 1994