

APPROVED

Date 12-16-97 RRC

CALHOUN COUNTY REMONUMENTATION.

CALHOUN COUNTY REMONUMENTATION LAND CORNER RECORDATION CERTIFICATE Filing Requirement of Act 74, Mich. P.A. 1970

STATE OF MICHIGAN
CALHOUN COUNTY
RECORDED

19 DEC 97 2:40 P.M.

ANNE B. NORLANDER
CLERK - REGISTER OF DEEDS

LIBER 1985 PAGE 533

Register of Deeds Stamp & File Number

For corners in

<u>CALHOUN</u>	Located In:	Corner Code #
(County)		
ATHENS TOWNSHIP		
1. Public Land Survey	T <u>4S</u> R <u>8W</u>	<u>1-7</u>
	T _____ R _____	_____
	T _____ R _____	_____
	T _____ R _____	_____
2. Property Controlling in Section	S _____ T _____ R _____	_____
	S _____ T _____ R _____	_____
3. Miscellaneous Property in Sec.	S _____ T _____ R _____	_____
	S _____ T _____ R _____	_____

4. Lot No. _____, Recorded Plat _____
 5. Private Claims _____

I, ROBERT R. CARR, in a field survey on DECEMBER 8, 1997 do hereby state that under requirements of P.A. 74, Michigan P.A. of 1970, the corner points mentioned in lines 1 and 2 above were in conformance with regulations and rules therefore as required in the current manual of survey instructions of the United States Department of the Interior, Bureau of Land Management or by a decree of a Court of Law and /or that the corner points mentioned in lines 3, 4 and 5 above were in conformance with the rules of the Michigan Board of Land Surveyors or by a Decree of a Court of Law; established, re-established, monumented, recovered, found as expressed below:

NOTE: Not more than 2 corners, all in the same town and range, may be recorded on this certificate.

A. Description of original monument and accessories and/or subsequent restoration:

1826 ROBERT CLARK D.S.
 1896 COURTRIGHT, RESURVEY; MEASURED WEST FROM SOUTH 1/4, SECTION 14, 40.20 CH AND FOUND REMAINS OF BEECH WITNESS STUMP S22-1/2°E,
 SET POST AT INTERSECTION OF FENCES, 6" CHERRY N85°W 12 LKS,
 W. OAK 13" S38-1/2°E 44-1/2 LKS
 1944 M.D.O.T. CALHOUN COUNTY RIGHT-OF-WAY MAP OF HIGHWAY M-66, SHEET NO. 65 SHOWS CORNER TO BE 2720.7 EAST OF CENTERLINE OF HIGHWAY M-66

	A	B	C	D	E	F	G	H	I	J	K	L	M
1													
2		6		5		4		3		2		1	
3													
4		7		8		9		10		11		12	
5													
6		18		17		16		15		14		13	
7									⊙				
8		19		20		21		22		23		24	
9													
10		30		29		28		27		26		25	
11													
12		31		32		33		34		35		36	
13													

SURVEY & REMONUMENTATION

APR 07 1998


SECTION

B. Description of corner evidence found and/or method applied in restoring or reestablishing corner:

RESURVEY WITNESSES GONE
 FOUND OLD WOOD CORNER POST SET IN CONCRETE
 RAN SOUTH LINE OF SECTION 15 FROM TILE FOUND AT SOUTHWEST CORNER TO FENCE CORNER POST AT SOUTHEAST CORNER AND FOUND M.D.O.T. DISTANCE (2720.7') FROM CENTERLINE OF HIGHWAY M-66 TO FALL ON CONCRETE BASE OF FENCE CORNER POST ACCEPTED THIS LOCATION AS TRUE PERPETUATION OF CORNER.
 CONCRETE BASE IS TOO ROUGH TO MARK, SET BERNTSEN MONUMENT AND CARSONITE WITNESS POST 2.0 FEET WEST OF CORNER LOCATION FOR REFERENCE MONUMENT

C. Description of monument for corner and accessories established to perpetuate locating the position of the corner:

WITNESSES TO BERNTSEN REFERENCE MONUMENT AND CARSONITE WITNESS POST LOCATED 2.0 FEET WEST OF TRUE CORNER.
 SET SPOTTER IN 10" CHERRY, EAST 8.77 FEET
 SET SPOTTER IN 8" CHERRY, S20°E 8.99 FEET
 WOOD FENCE POST IN CONCRETE BASE, EAST 2.0 FEET
 FENCES RUNNING EAST-WEST AND SOUTH
 CENTERLINE OF HIGHWAY M-66, WEST 2718.70 FEET.

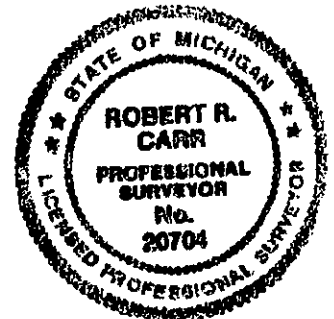

Signed by [Signature]
 Surveyor's Michigan License No. 20704

Date 12-15-97