

APPROVED

Date 8-17-94  
CALHOUN COUNTY  
REMONUMENTATION.

SURVEY &  
REMONUMENTATION

OCT 24 1994

CALHOUN COUNTY REMONUMENTATION  
LAND CORNER RECORDATION CERTIFICATE  
Filing Requirement of Act 74, Mich. P.A. 1970

COMMISSION

For corners in

|                                       |                           |               |
|---------------------------------------|---------------------------|---------------|
| CALHOUN<br>(County)                   | Located In:               | Corner Code # |
| ATHENS                                |                           |               |
| 1. Public Land Survey                 | T <u>4</u> S R <u>8</u> W | 1-9           |
|                                       | T _____ R _____           | _____         |
|                                       | T _____ R _____           | _____         |
|                                       | T _____ R _____           | _____         |
| 2. Property Controlling<br>in Section | S _____ T _____ R _____   | _____         |
|                                       | S _____ T _____ R _____   | _____         |
| 3. Miscellaneous<br>Property in Sec.  | S _____ T _____ R _____   | _____         |
|                                       | S _____ T _____ R _____   | _____         |

STATE OF MICHIGAN  
CALHOUN COUNTY  
RECORDED

18 AUG 94 12:13 P.M.

ANNE D. NORLANDER  
CLERK - REGISTER OF DEEDS

Register of Deeds Stamp & File Number

- 4. Lot No. \_\_\_\_\_, Recorded Plat \_\_\_\_\_
- 5. Private Claims \_\_\_\_\_

I, ROBERT R. CARR, in a field survey on JULY 13, 19 94, do hereby certify that under requirements of P.A. 74, Michigan P.A. of 1970, the corner points mentioned in lines 1 and 2 above were in conformance with regulations and rules therefore as required in the current manual of survey instructions of the United States Department of the Interior, Bureau of Land Management or by a decree of a Court of Law and/or that the corner points mentioned in lines 3, 4 and 5 above were in conformance with the rules of the Michigan Board of Land Surveyors or by a Decree of a Court of Law; established, re-established, monumented, re-monumented, recovered, found as expressed below:

**NOTE: Not more than 4 corners, all in the same town and range, may be recorded on this certificate.**

| A  | B  | C  | D  | E  | F  | G  | H | I | J | K | L | M |
|----|----|----|----|----|----|----|---|---|---|---|---|---|
| 2  | 6  | 5  | 4  | 3  | 2  | 1  |   |   |   |   |   |   |
| 3  |    |    |    |    |    |    |   |   |   |   |   |   |
| 4  | 7  | 8  | 9  | 10 | 11 | 12 |   |   |   |   |   |   |
| 5  |    |    |    |    |    |    |   |   |   |   |   |   |
| 6  | 18 | 17 | 16 | 15 | 14 | 13 |   |   |   |   |   |   |
| 7  |    |    |    |    |    |    |   |   |   |   |   |   |
| 8  | 19 | 20 | 21 | 22 | 23 | 24 |   |   |   |   |   |   |
| 9  |    |    |    |    |    |    |   |   |   |   |   |   |
| 10 | 30 | 29 | 28 | 27 | 26 | 25 |   |   |   |   |   |   |
| 11 |    |    |    |    |    |    |   |   |   |   |   |   |
| 12 | 31 | 32 | 33 | 34 | 35 | 36 |   |   |   |   |   |   |
| 13 |    |    |    |    |    |    |   |   |   |   |   |   |

A. Description of original monument and accessories and/or subsequent restoration:

ORIGINAL CORNER SET BY DEPUTY SURVEYOR, ROBERT CLARK 1826.  
RE-SURVEY BY COUNTY SURVEYOR F.A. COURTWRIGHT 1896.  
FOUND STONE FOR CORNER AND SET POST AND TWO WITNESSES.


B. Description of corner evidence found and/or method applied in restoring or reestablishing corner:

FOUND RE-SURVEY 3" HOLLOW TILE ON EAST SIDE OF LARGE STONE WITH 1/2" IRON OVER.  
REPLACED IRON & TILE WITH HARRISON MONUMENT 0.8 FT BELOW GRAVEL SURFACE WITH BROKEN TILE AROUND IT.

LIBER 1763 PAGE 766

C. Description of monument for corner and accessories established to perpetuate locating the position of the corner:

HARRISON MONUMENT  
IN CENTERLINE NORTH/SOUTH ROAD  
IN LINE WITH FENCE AND TREE ROW EAST  
NAIL & SPOTTER IN EAST SIDE OF 36" BASSWOOD N01°E 358.49 FT.  
NAIL & SPOTTER IN SOUTH SIDE OF 24" WALNUT S88°E 44.00 FT.  
NAIL & SPOTTER IN EASTERLY SIDE OF 8" ASH N31°E 57.82 FT.

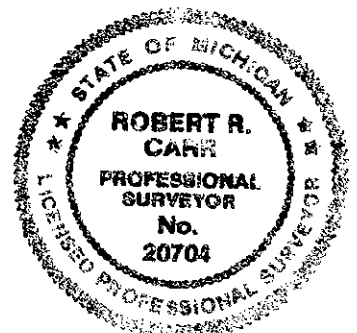

Signed by Robert R. Carr  
Surveyor's Michigan License No. 20704

Date AUGUST 15, 1994