

**SURVEY &
REMONUMENTATION**

OCT 24 1994

APPROVED

Date 8-17-94 WJD
**CALHOUN COUNTY
REMONUMENTATION.**

**COMMISSION
CALHOUN COUNTY REMONUMENTATION
LAND CORNER RECORDATION CERTIFICATE
Filing Requirement of Act 74, Mich. P.A. 1970**

STATE OF MICHIGAN
CALHOUN COUNTY
RECORDED

For corners in

<u>CALHOUN</u> <small>(County)</small>	Located In:	Corner Code #
ATHENS TWP.	T <u>4</u> S R <u>8</u> W	<u>1-11</u>
1. Public Land Survey	T _____ R _____	_____
	T _____ R _____	_____
	T _____ R _____	_____
2. Property Controlling in Section	S _____ T _____ R _____	_____
	S _____ T _____ R _____	_____
3. Miscellaneous Property in Sec.	S _____ T _____ R _____	_____
	S _____ T _____ R _____	_____
4. Lot No. _____, Recorded Plat _____		
5. Private Claims _____		

18 AUG 94 12:12 P.M.

ANNE B. NORLANDER
CLERK - REGISTER OF DEEDS

Register of Deeds Stamp & File Number

	A	B	C	D	E	F	G	H	I	J	K	L	M
2	6	5	4	3	2	1							
3													
4	7	8	9	10	11	12							
5													
6	13	17	16	15	14	13							
7													
8	19	20	21	22	23	24							
9													
10	30	29	28	27	26	25							
11													
12	31	32	33	34	35	36							
13													

I, ROBERT R. CARR, in a field survey on JUNE 7, 19 94, do hereby certify that under requirements of P.A. 74, Michigan P.A. of 1970, the corner points mentioned in lines 1 and 2 above were in conformance with regulations and rules therefore as required in the current manual of survey instructions of the United States Department of the Interior, Bureau of Land Management or by a decree of a Court of Law and/or that the corner points mentioned in lines 3, 4 and 5 above were in conformance with the rules of the Michigan Board of Land Surveyors or by a Decree of a Court of Law; established, re-established, monumented, re-monumented, recovered, found as expressed below:


NOTE: Not more than 4 corners, all in the same town and range, may be recorded on this certificate.

A. Description of original monument and accessories and/or subsequent restoration:
ORIGINAL CORNER SET BY DEPUTY SURVEYOR, ROBERT CLARK, 1826.
RE-SURVEY CORNER (TILE) SET BY COUNTY SURVEYOR, F.A. COURTWRIGHT, 1896.
L.W. CHASE, 1962, 1" PIPE IN HOLLOW TILE IN FENCE.
WILD CHERRY S33.5 FT.
4" ASH N ABOUT 20°E 136.5 FT.

B. Description of corner evidence found and/or method applied in restoring or reestablishing corner:
FOUND CONCRETE MONUMENT WITH BROKEN TILE AROUND IN NORTH/SOUTH FENCE.
REPLACED CONCRETE MONUMENT WITH BERNTSEN MONUMENT WITH BROKEN TILE AROUND.

LIBER 1763 PAGE 764

C. Description of monument for corner and accessories established to perpetuate locating the position of the corner:
BERNTSEN MONUMENT
FACE OF 4" STEEL FENCE POST FILLED WITH CONCRETE NORTH 6.02 FT.
NAIL & SPOTTER IN EAST SIDE OF 30" ASH NORTH 134.42 FT.
IN NORTH/SOUTH FENCE LINE
NO OTHER OBJECTS NEAR.

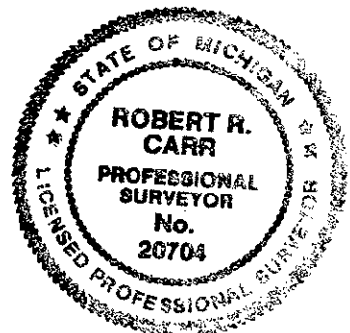

Signed by Robert R. Carr Date AUGUST 16, 1994
Surveyor's Michigan License No. 20704