

LAND CORNER RECORDATION CERTIFICATE

FILING REQUIREMENT OF ACT 74, MICH. P.A.1970

FOR CORNERS OF--	LOCATED IN--	CORNER CODE NUMBER
1. PUBLIC LAND SURVEY	17 T. 5 S., R. 13 W.	C-5
2. PROPERTY CONTROLLING IN SECTION	, T. _____ N. S., R. _____ E. W.	_____
3. MISCELLANEOUS PROPERTY IN SECTION	, T. _____ N. S., R. _____ E. W.	_____
4. LOT NO. _____, RECORDED PLAT _____		
5. PRIVATE CLAIMS _____		

Cass Co.

REGISTER OF DEEDS STAMP AND FILING NUMBER

I, Donald L. Bissell, do hereby certify that under requirements of P.A. 74, Michigan P.A. of 1970, the corner points mentioned in lines 1 and 2 above were, in a field survey on February, 1983, established, re-established, monumented, re-monumented, recovered or restored as expressed below and in conformance with regulations and rules therefore as required in the current manual of survey instructions of the United States Department of the Interior, Bureau of Land Management or by a decree of a court of law. Furthermore, that the corner points mentioned in lines 3, 4 and 5 above were, in a field survey on _____, 19____, found, recovered, restored, established or re-established as expressed below and in conformance with the rules of the Michigan State Board of Registration for Land Surveyors or, by a Decree of a Court of law:

A. Description of original monument and accessories and/or subsequent restoration:

C-5 Post set in 1887 by Bradt
 Recovered in 1892
 Set 3 posts around post in Marsh
 No trees near

B. Description of corner evidence found and/or method applied in restoring or re-establishing corner:

C-5 Measured from N $\frac{1}{4}$ corner, Section 18 and the E $\frac{1}{4}$ corner, Section 18 as measured in 1887 survey.
 Dug 10' dia. hole in swamp.
 Found 4" dia. stub of Cedar.
 Post 6" below surface.

C. Description of monument for corner and accessories established to perpetuate locating the position of the corner:

C-5 Set 1" x 6' pipe w/4" aluminum cap.
 Set 5" x 8' cedar post
 1'S.E. of corner.

SIGNED BY _____ DATE _____


SURVEYOR'S MICHIGAN REGISTRATION NO. _____

(SEAL)

FOR STATE AND UNITED STATES AGENCIES:

SIGNED BY _____ DATE _____

APPROVED AND SIGNED BY Donald L. Bissell DATE _____
CHIEF OF SURVEY PART
MICHIGAN REGISTERED LAND SURVEYOR

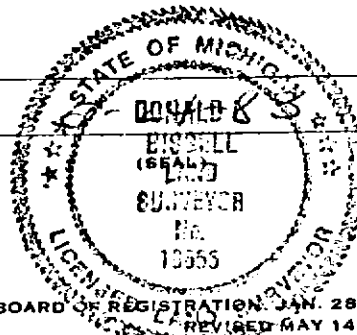

SURVEYOR'S MICHIGAN REGISTRATION NO. 18655