

Ratified by Peer Group
In Accordance With P.A. 345

Chairman Dale L. Kesler
Date Aug. 24, 1995

LAND CORNER RECORDATION CERTIFICATE
Filing Requirement of Act 74, Mich. P.A. 1970

STATE OF MICHIGAN
COUNTY OF CASS
Recorded

CASS COUNTY REMONUMENTATION

12-04-1995 11:53:35

Ann L. Simmons
REGISTER OF DEEDS

Liber **00003** Page **0021**

Register to cover Stamp Fee of \$1.00

CASS (County)	Located In:	Corner Code #
1. Public Land Survey	T <u>5</u> R <u>13</u>	<u>C-1</u>
	T _____ R _____	_____
	T _____ R _____	_____
	T _____ R _____	_____
2. Property Controlling in Section	S _____ T _____ R _____	_____
	S _____ T _____ R _____	_____
3. Miscellaneous Property in Sec.	S _____ T _____ R _____	_____
	S _____ T _____ R _____	_____
4. Lot No. _____, Recorded Plat _____		
5. Private Claims _____		

	A	B	C	D	E	F	G	H	I	J	K	L	M
2	6		5		4		3		2		1		
3													
4	7		8		9		10		11		12		
5													
6	18		17		16		15		14		13		
7													
8	19		20		21		22		23		24		
9													
10	30		29		28		27		26		25		
11													
12	31		32		33		34		35		36		
13													

I, DALE L. KESLER, in a field survey on DECEMBER 9, 1994, do hereby certify that under requirements of P.A. 74, Michigan P.A. of 1970, the corner points mentioned in lines 1 and 2 above were in conformance with regulations and rules therefore as required in the current manual of survey instructions of the United States Department of the Interior, Bureau of Land Management or by a decree of a Court of Law and/or that the corner points mentioned in lines 3, 4 and 5 above were in conformance with the rules of the Michigan Board of Land Surveyors or by a Decree of a Court of Law; established, re-established, monumented, re-monumented, recovered, found as expressed below:

NOTE: Not more than 4 corners, all in the same town and range, may be recorded on this certificate.

A. Description of original monument and accessories and/or subsequent restoration:

April 1830 - John Mullet, set post
6" Tamarack tree - South 49 East - 0.22 chains
6" Tamarack tree - South 29 West - 0.38 Chains

March 1871 - J.C. Bradt, County Surveyor, Identified
No witnesses

December 1897 - F.E. Smith, County Surveyor, identified good post and both witnesses.

B. Description of corner evidence found and/or method applied in restoring or reestablishing corner:


Found 1" iron pipe. Distances to adjacent corners were reasonable and consistent. Accepted iron as best evidence of corner.

MAR 27 1996
COMMISSION

C. Description of monument for corner and accessories established to perpetuate locating the position of the corner:

Set 3/4" iron pipe with aluminum cap in monument box in place of found 1" iron pipe and is accepted as a careful and faithful perpetuation of the position of the original corner.

- Set nail w/washer in 14" Elm - N. 40 W. 28.90'
- Set nail w/washer in 14" Beech - S. 1 E. 31.60'
- Set nail w/washer in 10" Maple S. 56 E. 37.95'
- Set nail w/washer in 20" Elm - S. 65 W. 54.20'
- Centerline of East & West Road 6.5' North

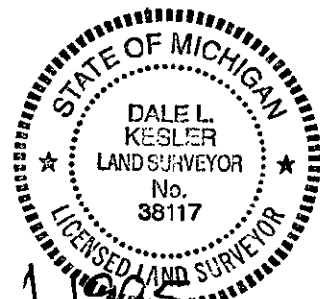

Signed by Dale L. Kesler

Date December 1, 1995

Surveyor's Michigan License No. 38117