

LAND CORNER RECORDATION CERTIFICATE

Filing Requirement of Act 74, Mich. P.A. 1970

STATE OF MICHIGAN
COUNTY OF CASS
Recorded

For corners in Volinia Township
Cass County
(County)

Located In: Corner Code #

1. Public Land Survey	T	53	R	14W	A-1
NW Corner, Section 6	T		R		
	T		R		
	T		R		
2. Property Controlling in Section	S		T	R	
	S		T	R	
3. Miscellaneous Property in Sec.	S		T	R	
	S		T	R	

10-13-1995 09:07:49

Ann L. Simmons
REGISTER OF DEEDS

Register of Deeds Stamp & File Number

Ratified by Peer Group
 In Accordance With P.A. 245
 Chairman Bill Calkins
 Date March 16, 1995

4. Lot No. _____, Recorded Plat _____
5. Private Claims _____

COMMISSION

A	B	C	D	E	F	G	H	I	J	K	L	M
2	6		5		4		3		2		1	
3												
4	7		8		9		10		11		12	
5												
6	16		17		16		15		14		13	
7												
8	19		20		21		22		23		24	
9												
10	30		29		28		27		26		25	
11												
12	31		32		33		34		35		36	
13												

I, Donald R. Gilchrist, in a field survey on December 23, 1994

do hereby certify that under requirements of P.A. 74, Michigan P.A. of 1970, the corner points mentioned in lines 1 and 2 above were in conformance with regulations and rules therefore as required in the current manual of survey instructions of the United States Department of the Interior, Bureau of Land Management or by a decree of a Court of Law and/or that the corner points mentioned in lines 3, 4 and 5 above were in conformance with the rules of the Michigan Board of Land Surveyors or by a Decree of a Court of Law; established, re-established, monumented, re-monumented, recovered, found as expressed below:

NOTE: Not more than 4 corners, all in the same town and range, may be recorded on this certificate.

A. Description of original monument and accessories and/or subsequent restoration:

A-1 SW Corner Sec. 31, corner common to Decatur & Hamilton Townships 3/25/1827 GOV.: WM. Brookfield DS: W. on S. boundary of Sec. 31 of Decatur Twp. 40.00 chs. (2640') Dr. Section Corner on 40" Poplar, continued W. for a total of 74.55 chs (4920.30') & intersected Range Line 230 lks (151.80') S. of temporary Six Mile Post. Set Post at intersection corner to townships. Witness: Beech 24" S.19°40"W. 8 lks (5.28'), Beech 8" N.10°30'E. 41 lks (27.06'). 6/15/1898 G. Muchler CS, found stake. 12/10/1908 W.H. Goss CS, no corner found. 4/11/1956, W.Q. Smith, CS, drawing shows corner. (Continued on back of Certificate)

B. Description of corner evidence found and/or method applied in restoring or reestablishing corner:

A-1 NW corner Section 6, T5S-R14W, Volinia Township Cas County, (Township corner). Corner evidence found: Found 1" iron pipe in C/L gravel road in line with fence to west (road has been cut down in this area -- high banks on sides of road). Replaced pipe with Standard Marker. Measured North 646.0' to C/L C.R. 669 pavement; North 2661.35' found 1/2" iron pipe 54' Southerly of S. end of bridge (44' long); S89°22'36" E. 4852.40' Mon Box C/L C.R. 668.

This Government Monument was restored by placing a Harrison Marker in its location as approved by the Cass County Peer Group at a meeting on March 16, 1995 and is accepted as a careful and faithful perpetuation of the position of the Original Government Corner.

C. Description of monument for corner and accessories established to perpetuate locating the position of the corner:


A-1 Standard Marker

West 32.73' Set nail & tag in S.E. corner of RR tie end post.
 N.34°E. 35.12' Set nail & tag in W. face 16" Oak.
 N.57°W. 44.98' Set nail & tag in N.E. face of 20" Oak.
 East 27.83' Set nail & tag in S. face of 7" Maple.

Signed by Donald R. Gilchrist

Date 10/3/95

Surveyor's Michigan License No. _____

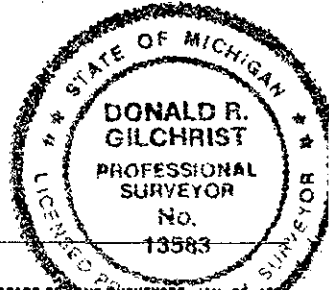

Donald R. Gilchrist, RLS #13583

A. Continued

10/10/80 B. Prestine, RLS

Found 1" iron.

Centerline 18" Hick - N60°W -45.4'

Centerline 28" TPLE W. Wood - N40°East 46.0'

Centerline 7" Map - East - 28.6'

Face RR Tie Post - W - 32.9'

In centerline of Road North and South

Dist. West 2623.41'

Dist. North 2661.35'

Dist. East 2243.33' to 1/4 Post, cont. 2608.53' to section corner.

Dist. South to iron 619.91' - total distance South to Quarter Post
2483.52'

3/30/95 D.R. Gilchrist, RLS - check distance from corner North to
centerline of C.R. 669. distance is 646' ±

Liber 00003 Page 0011

W. W. B. B. B.
B. B. B. B. B. B.