

LAND CORNER RECORDATION CERTIFICATE
Filing Requirement of Act 74, Mich. P.A. 1970
CASS COUNTY REMONUMENTATION

For corners in <u>CASS</u> (County)	Located In:	Corner Code #
1. Public Land Survey SW Cor. Sec. 6	T <u>5S</u> R <u>14W</u>	<u>A-3</u>
	T _____ R _____	_____
	T _____ R _____	_____
	T _____ R _____	_____
2. Property Controlling in Section	S _____ T _____ R _____	_____
	S _____ T _____ R _____	_____
3. Miscellaneous Property in Sec.	S _____ T _____ R _____	_____
	S _____ T _____ R _____	_____

STATE OF MICHIGAN
 COUNTY OF CASS
 Recorded

12-21-1999 13:24:28

Ann L. Simmons
 REGISTER OF DEEDS

Register of Deeds Stamp & File Number

Platified by Peer Group
 In Accordance With P.A. 345
 Chairman Dale Kesler
 Date Nov 23, 1999

4. Lot No. _____, Recorded Plat _____
 5. Private Claims _____

1	A	B	C	D	E	F	G	H	I	J	K	L	M
2		6		5		4		3		2		1	
3													
4		7		8		9		10		11		12	
5													
6		18		17		16		15		14		13	
7													
8		19		20		21		22		23		24	
9													
10		30		29		28		27		26		25	
11													
12		31		32		33		34		35		36	
13													

I, DALE L. KESLER, in a field survey on November 3, 1999 do hereby state that under requirements of P.A. 74, Michigan P.A. of 1970, the corner points mentioned in lines 1 and 2 above were in conformance with regulations and rules therefore as required in the current manual of survey instructions of the United States Department of the Interior, Bureau of Land Management or by a decree of a Court of Law and /or that the corner points mentioned in lines 3, 4 and 5 above were in conformance with the rules of the Michigan Board of Land Surveyors or by a Decree of a Court of Law; established, re-established, monumented, recovered, found as expressed below:

NOTE: Not more than 2 corners, all in the same town and range, may be recorded on this certificate.

A. Description of original monument and accessories and/or subsequent restoration:

- *April 24, 1830 John Mullet measured West 74.14 chains. Intersected West boundary 20 lks. South of post set post corner to Sec. 6 & 7. Witnesses: 14" Sugar N 20 deg. E 20 ch.; 24" Beech S 33 deg. E 24 ch.
- *November 8, 1973 Dennis Middleton, Smith & Smith, Inc. - found pipe LCRC Liber 1, Page 205. Witnesses: Old Blaze in 16" Oak Northeast 11.10'; Old Blaze in 10" Oak Northwest 7.20'; Corner in old fences - South and East.
- *January 1993 - Wightman-Peirce - found 1/2" iron fenceline to the South.


B. Description of corner evidence found and/or method applied in restoring or reestablishing corner:

Found 1/2" iron measures within reason to SE corner Section 1, T5S, R15W. Accepted 1/2" iron as best evidence of corner.

C. Description of monument for corner and accessories established to perpetuate locating the position of the corner:

Set 3" x 36" concrete monument with aluminum cap 1 foot below the surface in place of 1/2" iron rebar and is accepted as a careful and faithful perpetuation of the position of the original corner.

- Nail in R.R. Tie Post South 17.77'
- Nail in 42" Oak N 45 deg. W 56.83'
- Nail in 30" Oak N 20 deg. W 95.81'
- Telephone Riser S 60 deg. E 59.10'
- SE Cor. Sec. 1 T5S, R15W North 12.90'

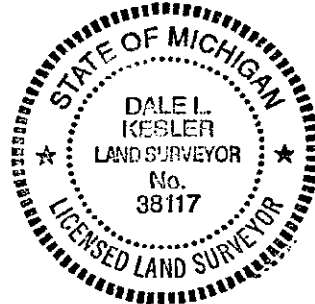

Signed by Dale Kesler
 Surveyor's Michigan License No. 38117

Date Dec 20, 1999

SURVEY &
 RE...

FEB 24 2000

SECTION