

FEB 19 1998

Liber 00003 Page 0153

SECTION

LAND CORNER RECORDATION CERTIFICATE
Filing Requirement of Act 74, Mich. P.A. 1970
CASS COUNTY REMONUMENTATION

Form with fields: For corners in CASS (County), Located in: T 5S R 14W, Corner Code # E-1. Includes sections for Public Land Survey, Property Controlling, and Miscellaneous Property.

STATE OF MICHIGAN
COUNTY OF CASS
Recorded

12-26-1997 12:02:30

Ann L. Simmons
REGISTER OF DEEDS

Register of Deeds Stamp & File Number

Vertical stamp: Ratified by Peer Group In Accordance With P.A. 245 Chairman Dale C Kesler Date Nov. 3, 1997

4. Lot No. , Recorded Plat
5. Private Claims

I, DALE L. KESLER, in a field survey on JULY 23, 1997 do hereby state that under requirements of P.A. 74, Michigan P.A. of 1970, the corner points mentioned in lines 1 and 2 above were in conformance with regulations and rules therefore as required in the current manual of survey instructions of the United States Department of the Interior, Bureau of Land Management or by a decree of a Court of Law and /or that the corner points mentioned in lines 3, 4 and 5 above were in conformance with the rules of the Michigan Board of Land Surveyors or by a Decree of a Court of Law; established, re-established, monumented, recovered, found as expressed below:

NOTE: Not more than 2 corners, all in the same town and range, may be recorded on this certificate.

A. Description of original monument and accessories and/or subsequent restoration:

*APR. 30, 1830 JOHN MULLETT. INTERSECT N BOUNDARY (CASS COUNTY) 12 LKS E OF POST TO SECTIONS 32 & 33-4-14.

*MAR. 6, 1882 AMOS SMITH. IDENTIFIED FOUND ALL THE WITNESSES FOR TWO CORNERS, ALSO POST AT THE CORNER OF SECTIONS 32 AND 33 TOWN 4-14. SET WALNUT POST IN SPRING GROUND (CASS CO.) WITNESSES FOR CASS CO.: 14" BEECH S 62 2/3 DEGREES W 38 LKS., 5" BEECH S 53 1/2 DEGREES E 35 LKS.

*JUNE 9, 1990 GEORGE MUTCHLER, COUNTY SURVEYOR, STAKE AND REMAINS OF ONE WITNESS TREE. REWIT: 16" BEECH SOUTH 50 DEGREES W 25 1/4 LKS., DRAWING SHOWS VAN BUREN CORNER EAST OF CASS'S CORNER 9.9'

*FEB. 28, 1924 T.A. SMITH. SECTION CORNER FOR DECATUR TOWNSHIP IS 10' EAST OF CORNER FOR VOLINIA TOWNSHIP.


B. Description of corner evidence found and/or method applied in restoring or reestablishing corner:

POSITION OF THE ORIGINAL CORNER WAS NOT FOUND AND WAS REESTABLISHED 7.92 FEET (12 LINKS) EAST AND ON LINE BETWEEN THE SOUTH QUARTER CORNER AND SE CORNER OF SECTION 33, T4S, R14W.

C. Description of monument for corner and accessories established to perpetuate locating the position of the corner:

SET CONCRETE MONUMENT WITH ALUMINUM CAP AND IS ACCEPTED AS A CAREFUL AND FAITHFUL REESTABLISHMENT OF THE POSITION OF THE ORIGINAL CORNER.

- NAIL & TAG 12" BEECH S 88 DEGREES W 26.12'
NAIL & TAG 26" OAK S 45 DEGREES W 25.30'
3' STEEL POST NORTH 0.25'
NAIL & TAG 16" CHERRY S 10 DEGREES W 36.40'
SW COR SEC 33, T4S, R14W WEST 7.92'

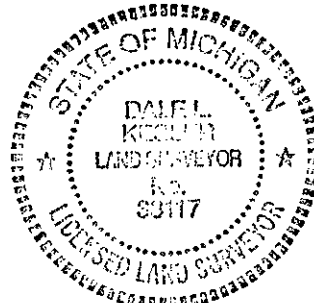

Signed by Dale L Kesler

Date 12/12/97

Surveyor's Michigan License No. 38117