

FEB 19 1998

Liber 00003 Page 0154

SECTION

LAND CORNER RECORDATION CERTIFICATE
Filing Requirement of Act 74, Mich. P.A. 1970
CASS COUNTY REMONUMENTATION

STATE OF MICHIGAN
COUNTY OF CASS
Recorded

12-26-1997 12:02:37

Ann L. Simmons
REGISTER OF DEEDS

Register of Deeds Stamp & File Number

Vertical stamp: Received by Dale C. Kesler, Nov 3, 1997

Form with fields: For corners in CASS (County), Located In: T 5S R 14W, Corner Code # F-1. Includes sections for Public Land Survey, Property Controlling, and Miscellaneous Property.

4. Lot No. , Recorded Plat
5. Private Claims

I, DALE L. KESLER, in a field survey on JULY 23, 1997 do hereby state that under requirements of P.A. 74, Michigan P.A. of 1970, the corner points mentioned in lines 1 and 2 above were in conformance with regulations and rules therefore as required in the current manual of survey instructions of the United States Department of the Interior, Bureau of Land Management or by a decree of a Court of Law and/or that the corner points mentioned in lines 3, 4 and 5 above were in conformance with the rules of the Michigan Board of Land Surveyors or by a Decree of a Court of Law; established, re-established, monumented, recovered, found as expressed below:

NOTE: Not more than 2 corners, all in the same town and range, may be recorded on this certificate.

A. Description of original monument and accessories and/or subsequent restoration:

- * 1827 WILLIAM BROOKFIELD. SET QUARTER SECTION POST. 18" ASH N 8 3/4 DEGREES E 21 LKS., 9" ASH N 80 1/8 DEGREES W 33 LKS.
* FEB. 16, 1871 J. BRADT, CASS COUNTY SURVEYOR, N 1/4 CORNER IDENTIFIED, RE-WITNESSES: 4" OAK S 15 1/2 DEGREES W 33 LKS., 8" OAK S 47 DEGREES E 36 LKS.
* APPROX. 1885 CASS COUNTY SURVEYOR, IDENTIFIED WITNESSES GOOD, PUT STONE DOWN. NO WITNESSES.
* JUNE 9, 1900 GEORGE MUTCHLER, COUNTY SURVEYOR. STONE, NO WITNESSES REMAIN.
* SEPT. 13, 1971 DON PEIRCE (CASS COUNTY), FOUND STONE. WITNESSES: 20" OAK S 26 DEGREES W 27.78' FENCE INTERSECTION


B. Description of corner evidence found and/or method applied in restoring or reestablishing corner:

FOUND STONE NEXT TO FENCE INTERSECTION. ACCEPTED STONE AS BEST EVIDENCE OF CORNER.

C. Description of monument for corner and accessories established to perpetuate locating the position of the corner:

SET HARRISON MARKER IN PLACE OF STONE AND IS ACCEPTED AS A CAREFUL AND FAITHFUL PERPETUATION OF THE POSITION OF THE ORIGINAL CORNER.

- NAIL & TAG 16" MAPLE N 34 DEGREES E 19.21'
NAIL & TAG 16" ASH N 62 DEGREES E 16.55'
NAIL & TAG 16" MAPLE S 14 DEGREES W 28.90'
R.R. RAIL POST EAST 0.72'

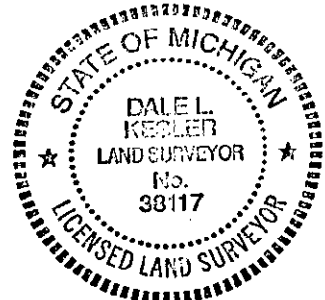

Signed by Dale C. Kesler

Date 12/12/97

Surveyor's Michigan License No. 38117