

**SURVEY & REMONUMENTATION**

FEB 19 1998

Liber **00003** Page **0150**

**SECTION**

**LAND CORNER RECORDATION CERTIFICATE  
Filing Requirement of Act 74, Mich. P.A. 1970  
CASS COUNTY REMONUMENTATION**

For corners in <u>CASS</u> (County)	Located In:	Corner Code #
1. Public Land Survey VOLINIA TWP.	T <u>5S</u> R <u>14W</u>	<u>G-1</u>
	T _____ R _____	_____
	T _____ R _____	_____
	T _____ R _____	_____
2. Property Controlling in Section	S _____ T _____ R _____	_____
	S _____ T _____ R _____	_____
3. Miscellaneous Property in Sec.	S _____ T _____ R _____	_____
	S _____ T _____ R _____	_____

STATE OF MICHIGAN  
COUNTY OF CASS  
Recorded

12-26-1997 12:01:54

Ann L. Simmons  
REGISTER OF DEEDS

Register of Deeds Stamp & File Number

Ratified by Peer Group  
 In Accordance With P.A. 945  
 Chairman Dale Kesler  
 Nov 1997

4. Lot No. \_\_\_\_\_, Recorded Plat \_\_\_\_\_  
 5. Private Claims \_\_\_\_\_

I, DALE L. KESLER, in a field survey on NOV. 19, 1997 do hereby state that under requirements of P.A. 74, Michigan P.A. of 1970, the corner points mentioned in lines 1 and 2 above were in conformance with regulations and rules therefore as required in the current manual of survey instructions of the United States Department of the Interior, Bureau of Land Management or by a decree of a Court of Law and /or that the corner points mentioned in lines 3, 4 and 5 above were in conformance with the rules of the Michigan Board of Land Surveyors or by a Decree of a Court of Law; established, re-established, monumented, recovered, found as expressed below:

**NOTE: Not more than 2 corners, all in the same town and range, may be recorded on this certificate.**

**A. Description of original monument and accessories and/or subsequent restoration:**

- \*APR. 24, 1830 JOHN MULLETT. NORTH BETWEEN SECTIONS 3 & 4, 77.04 INT. N BOUNDARY AT POST.
- \*FEB. 16, 1871 J.E. BRADT, CASS COUNTY SURVEYOR. NE COR IDENTIFIED GOV. WITNESS THERE.
- \*APPROX. 1885 CASS COUNTY SURVEYOR (NO NAME). IDENTIFIED FROM GOV. WITNESSES. FOUND STONE SET LONG AGO. 30" OAK S 84 DEGREES E 50 LKS., 24" OAK S 21 1/4 DEGREES E 101 3/4 LKS.
- \*JUNE 9, 1900 GEORGE MUTCHLER. STONE PRESENT, REMAINS OF ONE WITNESS PRESENT, REWITNESS: 24" OAK N 18 W 146 1/2 LKS, 36" OAK S 83 3/4 E 49 1/4 LKS.
- \*JULY 2, 1928 T.A. SMITH FOUND STONE. 12" HICKORY WEST 57.20', NEAR COR. OF BRICK FOUNDATION S 55 W 75.8'
- \*JUNE 7, 1974 SMITH & SMITH, INC. FOUND SPIKE IN PAVING ON OLD WITNESS DIMENSIONS, DUG, FOUND NOTHING, SET IRON ON OLD WITNESS. NW COR. BRICK FND. SW 75.8', CATALPA STUMP SW 59.3', FND NAIL IN POLE SE 46.55', FND NAIL IN POLE NW 24.55'
- \*APR. 6, 1994 ROBERT R. CARR. FOUND IRON STAKE. U POLE N 51 DEGREES E 43.07', U POLE S 27 DEGREES E 46.87', U POLE N 74 DEGREES W 21.14', CORNER OF BRICK FND. S 55 DEGREES W 82.70', 1' +/- W OF CENTERLINE OF N/S ROAD IN CENTERLINE OF ROAD EAST.


**B. Description of corner evidence found and/or method applied in restoring or reestablishing corner:**

FOUND 1/4" IRON ROD. ACCEPTED 1/4" IRON ROD AS BEST EVIDENCE OF CORNER.

**C. Description of monument for corner and accessories established to perpetuate locating the position of the corner:**

SET HARRISON MARKER IN MONUMENT BOX IN PLACE OF 1/4" IRON ROD AND IS ACCEPTED AS A CAREFUL AND FAITHFUL PERPETUATION OF THE POSITION OF THE ORIGINAL CORNER.

- NAIL & TAG UTILITY POLE N 40 DEGREES E 49.20'
- NAIL & TAG POWER POLE S 37 DEGREES E 44.30'
- NAIL & TAG POWER POLE N 74 DEGREES W 21.14'
- SE COR. BRICK FOUNDATION S 55 DEGREES W 82.70'
- NE COR. PORCH SW 76.10'

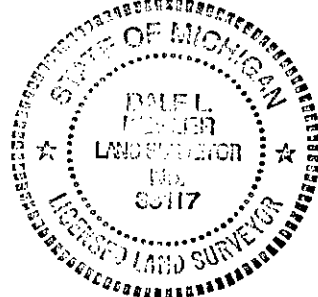

Signed by Dale L. Kesler  
 Surveyor's Michigan License No. 38117

Date 12/13/97

	A	B	C	D	E	F	G	H	I	J	K	L	M
1													
2		6		5		4		3		2		1	
3													
4		7		8		9		10		11		12	
5													
6		16		17		16		15		14		13	
7													
8		19		20		21		22		23		24	
9													
10		30		29		28		27		26		25	
11													
12		31		32		33		34		35		36	
13													