

MAR 11 1998

Liber 00003 Page 0147

SECTION

LAND CORNER RECORDATION CERTIFICATE
Filing Requirement of Act 74, Mich. P.A. 1970
CASS COUNTY REMONUMENTATION

For corners in CASS (County)

Located In: Corner Code #

- 1. Public Land Survey VOLINIA TWP. T 5S R 14W I-1
2. Property Controlling in Section S T R
3. Miscellaneous Property in Sec. S T R

STATE OF MICHIGAN
COUNTY OF CASS
Recorded

12-26-1997 12:01:10

Ann L. Simmons
REGISTER OF DEEDS

Register of Deeds Stamp & File Number

Printed by Peer Group
In Accordance With P.A. 345
Chairman Dale C. Kesler
Date Dec. 9, 1997

4. Lot No. Recorded Plat
5. Private Claims

I, DALE L. KESLER, in a field survey on NOV. 28, 1997 do hereby state that under requirements of P.A. 74, Michigan P.A. of 1970, the corner points mentioned in lines 1 and 2 above were in conformance with regulations and rules therefore as required in the current manual of survey instructions of the United States Department of the Interior, Bureau of Land Management or by a decree of a Court of Law and /or that the corner points mentioned in lines 3, 4 and 5 above were in conformance with the rules of the Michigan Board of Land Surveyors or by a Decree of a Court of Law; established, re-established, monumented, recovered, found as expressed below:

Grid table with columns A-L and rows 1-13. A dot is present in cell I-1.

NOTE: Not more than 2 corners, all in the same town and range, may be recorded on this certificate.

A. Description of original monument and accessories and/or subsequent restoration:

- *APRIL 24, 1830 JOHN MULLETT. MEASURED NORTH BETWEEN SECTIONS 2 AND 3, 76.41 CHAINS, INTERSECTED N. BOUNDARY AT POST.
*JUNE 9, 1900 GEORGE MUTCHLER (COUNTY SURVEYOR). STONE PRESENT WITNESS VERY DISTANT TO FIND NOW. RE-WITNESS: 2" ASH N 2 DEGREES E 46 1/4 LKS., 28" OAK N 88 3/4 DEGREES W 12.93 LKS.
*AUG. 30, 1905 J.S. HAINES. FOUND STONE.
*SEPT. 16, 1912 W.V. ACKLEY. MAKES REFERENCE TO MUTCHLER SURVEY.


B. Description of corner evidence found and/or method applied in restoring or reestablishing corner:

FOUND 1/2" BOLT IN ASPHALT, DUG BELOW, FOUND STONE. DISTANCES TO ADJACENT CORNERS WERE REASONABLE AND CONSISTENT. ACCEPTED 1/2" BOLT AS BEST EVIDENCE OF CORNER.

C. Description of monument for corner and accessories established to perpetuate locating the position of the corner:

SET HARRISON MARKER IN PLACE OF 1/2" BOLT IN A MONUMENT BOX AND IS ACCEPTED AS THEE BEST AVAILABLE EVIDENCE OF THE POSITION OF THE ORIGINAL CORNER.

- FENCE CORNER POST S 36 DEGREES 58' E 36.03'
NAIL & TAG POWER POLE S 32 DEGREES 55' W 41.73'
R R FENCE POST S 36 DEGREES 57' W 38.64'
NAIL & TAG POWER POLE N 10 DEGREES 41' W 31.77'
NAIL & TAG 12" HICKORY S 48 DEGREES 18' W 60.20'

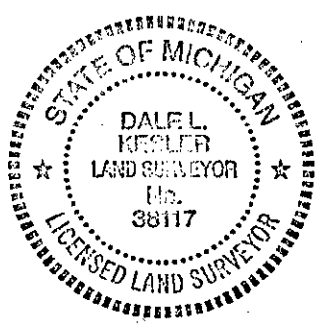

Signed by Dale C. Kesler

Date 12/17/97

Surveyor's Michigan License No. 38117