

SURVEY & REMONUMENTATION

MAR 11 1998

Liber **00003** Page **0145**

LAND CORNER RECORDATION CERTIFICATE
Filing Requirement of Act 74, Mich. P.A. 1970
CASS COUNTY REMONUMENTATION

SECTION

For corners in
CASS
 (County)

Located In: Corner Code #

- | | | |
|---------------------------------------|--------------------------|------------|
| 1. Public Land Survey
VOLINIA TWP. | T <u>5S</u> R <u>14W</u> | <u>J-1</u> |
| | T _____ R _____ | _____ |
| | T _____ R _____ | _____ |
| | T _____ R _____ | _____ |
| 2. Property Controlling
in Section | S _____ T _____ R _____ | _____ |
| | S _____ T _____ R _____ | _____ |
| 3. Miscellaneous
Property in Sec. | S _____ T _____ R _____ | _____ |
| | S _____ T _____ R _____ | _____ |

STATE OF MICHIGAN
 COUNTY OF CASS
 Recorded

12-26-1997 12:00:48

Ann L. Simmons
 REGISTER OF DEEDS

Register of Deeds Stamp & File Number

Replied by Peter Coble
 In Accordance with P.A. 845
 Chairman Dale L. Kesler
 Date Dec. 4, 1997

4. Lot No. _____, Recorded Plat _____
 5. Private Claims _____

I, DALE L. KESLER, in a field survey on NOV. 28, 1997 do hereby state that under requirements of P.A. 74, Michigan P.A. of 1970, the corner points mentioned in lines 1 and 2 above were in conformance with regulations and rules therefore as required in the current manual of survey instructions of the United States Department of the Interior, Bureau of Land Management or by a decree of a Court of Law and /or that the corner points mentioned in lines 3, 4 and 5 above were in conformance with the rules of the Michigan Board of Land Surveyors or by a Decree of a Court of Law; established, re-established, monumented, recovered, found as expressed below:

	A	B	C	D	E	F	G	H	I	K	L	M
1												
2	6		5		4		3		2		1	
3												
4	7		8		9		10		11		12	
5												
6	18		17		16		15		14		13	
7												
8	19		20		21		22		23		24	
9												
10	30		29		28		27		26		25	
11												
12	31		32		33		34		35		36	
13												

NOTE: Not more than 2 corners, all in the same town and range, may be recorded on this certificate.

A. Description of original monument and accessories and/or subsequent restoration:


- * 1827 WILLIAM BROOKFIELD. SET QUARTER SECTION POST. 12" BURR OAK N 25 1/3 DEGREES W 15.86 LKS., 12" BURR OAK N 2 1/2 DEGREES W 17.63 LKS.
- * AUG. 30, 1905 J.S. HAINES (CASS COUNTY SURVEYOR), ESTABLISHED HALF WAY PIPE. 8" ELM S 60 3/4 DEGREES E 51 2/3 LKS., 14" CHERRY N 72 3/4 DEGREES W 97 LKS.
- * SEPT. 15, 1941 T.A. SMITH. MEASURED SOUTH LINE OF THE SW 1/4, SECTION 35 - 2645.85'.

B. Description of corner evidence found and/or method applied in restoring or reestablishing corner:

CORNER NOT FOUND. REESTABLISHED CORNER AT THE MIDWAY POINT BETWEEN THE SW CORNER OF SECTION 35, T4S, R14W, AND THE SE CORNER OF SECTION 35, T4S, R14W, DECATUR TOWNSHIP, VAN BUREN COUNTY, MICHIGAN.

C. Description of monument for corner and accessories established to perpetuate locating the position of the corner:

- SET HARRISON MARKER IN MONUMENT BOX AND IS ACCEPTED AS A CAREFUL AND FAITHFUL REESTABLISHMENT OF THE POSITION OF THE ORIGINAL CORNER.
- P.K. NAIL & BOTTLECAP IN POWER POLE N 31 DEGREES 36' 50" E 39.05'
 - R.R. RAIL POST S 5 DEGREES 35' 40" E 28.68'
 - NAIL & TAG 12" CHERRY TREE S 10 DEGREES 35' E 50.87'
 - NAIL & TAG POWER POLE N 84 DEGREES 07' W 300.07'
 - C.L. EAST & WEST ROAD NORTH 3.00'

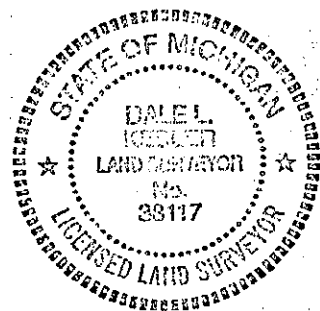

Signed by Dale L. Kesler

Date 12/23/97

Surveyor's Michigan License No. 38117