

LAND CORNER RECORDATION CERTIFICATE
Filing Requirement of Act 74, Mich. P.A. 1970
CASS COUNTY REMONUMENTATION

For corners in CASS (County) Located In: Corner Code #
1. Public Land Survey SE Cor. Sec. 12 T 5S R 15W M-5
2. Property Controlling in Section S T R
3. Miscellaneous Property in Sec. S T R

STATE OF MICHIGAN COUNTY OF CASS Recorded 12-21-1999 13:25:15 Ann L. Simmons REGISTER OF DEEDS
Ratified by Peer Group In Accordance With P.A. 345 Chairman Date Nov 23, 1999
Register of Deeds Stamp & File Number

4. Lot No. , Recorded Plat
5. Private Claims

I, DALE L. KESLER, in a field survey on November 2, 1999 do hereby state that under requirements of P.A. 74, Michigan P.A. of 1970, the corner points mentioned in lines 1 and 2 above were in conformance with regulations and rules therefore as required in the current manual of survey instructions of the United States Department of the Interior, Bureau of Land Management or by a decree of a Court of Law and /or that the corner points mentioned in lines 3, 4 and 5 above were in conformance with the rules of the Michigan Board of Land Surveyors or by a Decree of a Court of Law; established, re-established, monumented, recovered, found as expressed below:

Grid table with columns A-M and rows 1-13. Cell (5, M) contains a black dot.

NOTE: Not more than 2 corners, all in the same town and range, may be recorded on this certificate.

A. Description of original monument and accessories and/or subsequent restoration:


March 20, 1827 William Brookfield set post in marsh. Witnesses: 15" W. Oak S 1/2 W 4.05; 15" W. Oak N 65 1/4 W 3.50. Government entered swamp from South 244.8 South of M-5

B. Description of corner evidence found and/or method applied in restoring or reestablishing corner:

Corner location is in a swamp. No evidence of the corner was found. Re-established corner by prorating from the West 1/4 Corner, Section 13 and the W 1/4 Corner, Section 12.

C. Description of monument for corner and accessories established to perpetuate locating the position of the corner:

Set 1 1/4" x 72" galvanized pipe with coupling with aluminum cap in swamp and is accepted as a careful and faithful re-establishment of the position of the original corner.
C/L 18" Hickory South 252.00'
Edge Marsh South 245.00'
Edge Marsh West 176.00'
Center 26" Oak West 215.70'
Center 54" Triple Cherry S 40 deg. W 238.7'

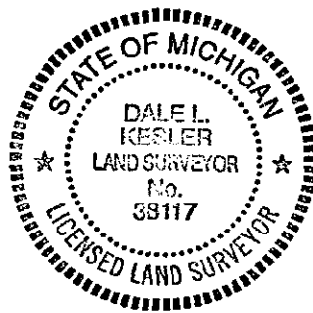

Signed by Dale L. Kesler
Surveyor's Michigan License No. 38117

Date Dec 20, 1999

RECORDED

FEB 24 2000

SECTION