

**SURVEY & REMONUMENTATION**

JAN 21 1999

**CASS COUNTY REMONUMENTATION  
LAND CORNER RECORDATION CERTIFICATE  
Filing Requirement of Act 74, Mich. P.A. 1970**

SECTION

For corners in **CASS COUNTY** Located in: **SILVER CREEK TWP.** Corner Code # **(A-6) WEST 1/4 CORNER SEC.18**

STATE OF MICHIGAN  
COUNTY OF CASS  
Recorded

12-22-1998 15:39:47

Ann L. Simmons  
REGISTER OF DEEDS

Ratified by Peer Group

In Accordance With P.A. 345

Chairman

Register of Deeds Stamp & File Number

- 1. Public Land Survey      T 5S    R 16W    A-6
- T \_\_\_\_\_ R \_\_\_\_\_
- T \_\_\_\_\_ R \_\_\_\_\_
- T \_\_\_\_\_ R \_\_\_\_\_
- 2. Property Controlling S \_\_\_\_\_ T \_\_\_\_\_ R \_\_\_\_\_
- in Section                    S \_\_\_\_\_ T \_\_\_\_\_ R \_\_\_\_\_
- 3. Miscellaneous            S \_\_\_\_\_ T \_\_\_\_\_ R \_\_\_\_\_
- Property in Sec.          S \_\_\_\_\_ T \_\_\_\_\_ R \_\_\_\_\_

- 4. Lot No \_\_\_\_\_, Recorded Plat \_\_\_\_\_
- 5. Private Claims \_\_\_\_\_

I, **Alan Bartlett** in a field survey on **November 13, 1998** hereby certify that under requirements of P.A. 74, Michigan P.A. of 1970, the corner points mentioned in lines 1 and 2 above were in conformance with regulations and rules therefore as required in the current manual of survey instructions of the United States Department of the Interior, Bureau of Land Management or by a decree of a Court of Law and/or that the corner points mentioned in lines 3, 4 and 5 above were in conformance with the rules of the Michigan Board of Land Surveyors or by a Decree of a Court of Law; established, re-established, monumented, re-monumented, recovered, found as expressed below:

**NOTE: Not more than 4 corners, all in the same town and range, may be recorded on this certificate.**

	A	B	C	D	E	F	G	H	I	J	K	L	M
2	8	5	4	3	2	1							
3													
4	7	8	9	10	11	12							
5													
6	18	17	16	15	14	13							
7													
8	19	20	21	22	23	24							
9													
10	30	29	28	27	26	25							
11													
12	31	32	33	34	35	36							
13													

A. Description of original monument and accessories and/or subsequent restoration:

(CORNER NOT SET IN ORIGINAL GOVERNMENT SURVEY)  
(PLEASE SEE BACK PAGE)

Liber **00003** Page **0185**

B. Description of corner evidence found and/or method applied in restoring or reestablishing corner:

This corner not set in original government survey. This Corner reestablished using best available evidence and set as a 1/4 mile split between A-7 and A-5. This corner position approved by Cass County Remonumentation Peer Group of Surveyors on October 21, 1998.


C. Description of monument for corner and accessories established to perpetuate locating the position of the corner:

Set Cass County Remonumentation Cap and Galvanized pipe in monument box 5' South of edge of bit on Center Line of extended Columbia Ave.

	witnesses	
S80E	Nail and Flasher South side 12" Hemlock	146.00'
N45W	P.K. South side of P.P.	85.17'
N30W	Nail and Flasher S side 6" Tree	76.32'
North	Berrien County Monument in Mon. Box	41.92'

This position not established in original government survey. This Monument is accepted as the best available evidence of the position of this corner.

Signed by Alan K. Bartlett Date 12/16/98  
Surveyor's Michigan License No. **35988**

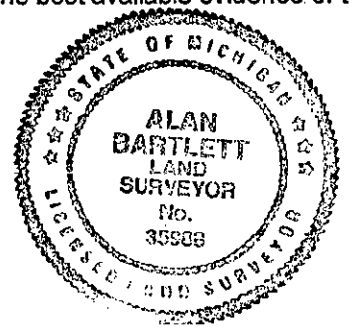

A-6 WEST 1/4 CORNER SECTION 18 SILVER CREEK TWP. T5S, R16W (not GLO corner)

Sept. 1882 Amos Smith County Surveyor  
39.95 Chains South to SW Corner Section 18.

Misc Field Diagram  
39.72 Chains to SW Corner

J. H. Dewey Notes (no date)

Stone & Iron - On N. Side Big Maple Tree  
40" Walnut S20E 29.9'  
24" Maple N20E 47.0'  
Cement Post N40E 39.5'

Shows: Jog Rec 43.23' M. 42.9' South of Ber. Co. Corner

Landmark Technologies 1998 Alan Bartlett #35988

(Not found)

SURVEY &  
REMONUMENTATION

JAN 21 1999

SECTION

Liber 00003 Page 0186