

SURVEY & REMONUMENTATION

JAN 21 1999

**CASS COUNTY REMONUMENTATION
LAND CORNER RECORDATION CERTIFICATE
Filing Requirement of Act 74, Mich. P.A. 1970**

SECTION

For corners in **CASS COUNTY** Located in: **SILVER CREEK TWP.** Corner Code # **(A-7) SW CORNER SEC.18**

1. Public Land Survey T 5S R 16W A-7
- T _____ R _____ _____
- T _____ R _____ _____
- T _____ R _____ _____
2. Property Controlling S _____ T _____ R _____
- in Section S _____ T _____ R _____
3. Miscellaneous S _____ T _____ R _____
- Property in Sec. S _____ T _____ R _____
4. Lot No _____, Recorded Plat _____
5. Private Claims _____

STATE OF MICHIGAN
COUNTY OF CASS
Recorded

12-22-1998 15:40:04

Ann L. Simmons
REGISTER OF DEEDS

Register of Deeds Stamp & File Number

Validated by Peer Group

In Accordance With P.A. 345

Chairman *[Signature]*
P.A. 79 1978

I, **Alan Bartlett** in a field survey on **November 13, 1998** hereby certify that under requirements of P.A. 74, Michigan P.A. of 1970, the corner points mentioned in lines 1 and 2 above were in conformance with regulations and rules therefore as required in the current manual of survey instructions of the United States Department of the Interior, Bureau of Land Management or by a decree of a Court of Law and/or that the corner points mentioned in lines 3, 4 and 5 above were in conformance with the rules of the Michigan Board of Land Surveyors or by a Decree of a Court of Law; established, re-established, monumented, re-monumented, recovered, found as expressed below:

	A	B	C	D	E	F	G	H	I	J	K	L	M
2	6	5	4	3	2	1							
3													
4	7	8	9	10	11	12							
5													
6	18	17	16	15	14	13							
7													
8	19	20	21	22	23	24							
9													
10	30	29	28	27	26	25							
11													
12	31	32	33	34	35	36							
13													

NOTE: Not more than 4 corners, all in the same town and range, may be recorded on this certificate.

Liber 00003 Page 0187

A. Description of original monument and accessories and/or subsequent restoration:

(PLEASE SEE BACK PAGE)

B. Description of corner evidence found and/or method applied in restoring or reestablishing corner:

Corner reestablished from GLO jog distance of 66 links (43.56') south of N.E. corner of Section 24 T5S R16W. This corner approved by the Cass County Remonumentation Peer Group of Surveyors on October 21, 1998.


C. Description of monument for corner and accessories established to perpetuate locating the position of the corner:

Set Concrete Monument with Cass County Remonumentation Cap 1" above ground with stones around.

Witnesses

- N85E Set Nail and Flasher S. side of 18" Maple 24.32'
- S80E Set Nail and Flasher N. side of 24" Maple 25.83'
- S10W Set Nail and Flasher E. side of 20" Maple 5.82'
- N25W Set Nail and Flasher in 18" Maple 17.53'

Corner is accepted as a careful and faithful perpetuation of the position of the original corner.

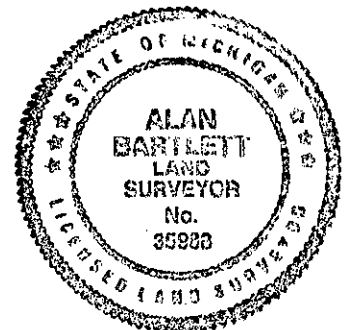

Signed by *Alan K. Bartlett* Date 12/16/98
Surveyor's Michigan License No. 35988

A-7 SW CORNER SECTION 18 SILVER CREEK TWP. T5S, R16W

GLO March 17 1827 William Brookfield
West between 18 & 19
77.13 Intersect West Boundary
66 lks South of E 1/4 Post.

Witnesses

W. Wood 36 N51E 18
Sug 9 S44E 42

Sept. 1882 Amos Smith County Surveyor
39.95 Chains North to W1/4 Corner Section 18.

Misc Field Diagram

39.72 Chains to W1/4 Corner

Landmark Technologies 1998 Alan Bartlett #35988

(Not found)

**SURVEY &
REMONUMENTATION**

JAN 21 1999

SECTION

Liber **00003** Page **0188**